

Plugged and Abandoned
 MISSISSIPPI
 BOARD OF WATER COMMISSIONERS
 416 North State Street
 Jackson, Mississippi 39201

Code

GW-01850

Neshoba

H 219

10-29-68

WATER WELL DRILLERS LOG

10-29 1968 Common Drilling Service Neshoba
 date well completed firm name county well located

LANDOWNER: East Side

description of formations encountered

from to

Water association

Philadelphia Min
 (mailing address)

| | | |
|-------------|-----|------|
| <u>Sand</u> | 0 | 76 |
| <u>Clay</u> | 75 | 135 |
| <u>Sand</u> | 130 | 196 |
| <u>Clay</u> | 195 | 680 |
| <u>Sand</u> | 500 | 680 |
| <u>Sand</u> | | 1095 |

WELL LOCATION:

sec. 17 T. 11 N R. 13 E
 S W
7 miles E of Philadelphia
 (distance) (direction) (nearest town)

WELL PURPOSE: Municipal
 (home, irrigation, municipal, industrial)

WELL COMPLETION DATA:

- (1) diameter (inches) 2"
- (2) total depth (feet) 692
- (3) static water level (feet) _____ below
 top of ground. above
- (4) casing Steel
 (material) (depth) _____
 _____ if telescope see back.
 (size)
- (5) screen _____
 (length) (depth to top) _____

 (size) (material)
- (6) pump _____
 (HP) (yield gpm) _____

 (type power)
- (7) electric log _____
 (yes or no) _____

 (organization running log)
- (8) how well bottom plugged _____

Code


FEB 12 1969

MISS. RD. OF
 WATER COMM.

DRILLERS REMARKS: Test
Well For Association

If well telescopes please sketch and show depths.

GROUND LEVEL

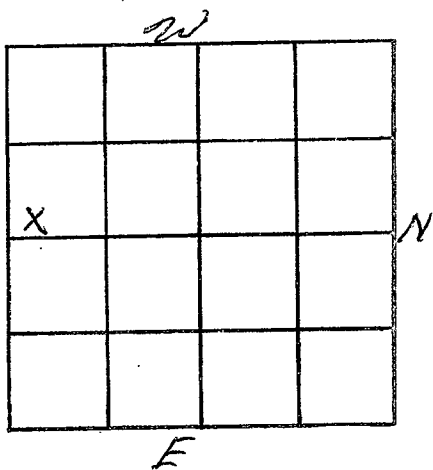

SECTION 15

Please indicate well location X.

ADDITIONAL INFORMATION

If more than one screen, show locations of each on sketch.