

Neshoba
 H 20
 12-68

MISSISSIPPI
 BOARD OF WATER COMMISSIONERS
 416 North State Street
 Jackson, Mississippi 39201

1001

WATER WELL DRILLERS LOG

Oglethorpe Drilling Co. Neshoba

date well completed 19 firm name county well located

LANDOWNER:

Ray Burtan
 Route 2 Phila. Miss
 (mailing address)

description of formations encountered

from to

Red clay 0 20
 Red sand 20 30
 Blue chalk 30 120
 Blue sand 120 168

WELL LOCATION:

sec. 16 T. 11 N. R. 13 E.
 S W
 7 1/2 miles East of Phila
 (distance) (direction) (nearest town)

WELL PURPOSE: ~~Home + Muni~~
 (home, irrigation, municipal, industrial)

WELL COMPLETION DATA:

- (1) diameter (inches) 4"
- (2) total depth (feet) 168
- (3) static water level (feet) 85 ^{below} above top of ground.
- (4) casing Steel 126
 (material) (depth)
- _____ If telescope see back.
 (size)
- (5) screen 20 168-148
 (length) (depth to top)
- 2" Stainless steel
 (size) (material)
- (6) pump 2' 22
 (HP) (yield gpm)
- R.P.A.
 (type power)
- (7) electric log NO.
 (yes or no)
- _____ (organization running log)
- (8) how well bottom plugged Painted

DRILLERS REMARKS:

DEC 11 1968

MISS. RT. OF
 WATER COMMISSIONERS

If well telescopes please sketch and show depths.

GROUND LEVEL

4"

126


coarse

21

2"

20'

paint's

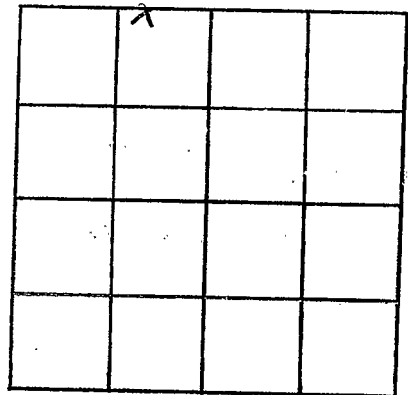

SECTION 16

Please indicate well location X.

ADDITIONAL INFORMATION

If more than one screen, show locations of each on sketch.