

CODED

MISSISSIPPI
BOARD OF WATER COMMISSIONERS
416 North State Street
Jackson, Mississippi 39201

WATER WELL DRILLERS LOG

CODED

Neshoba
H 21
3-14-69

March 14 19 69 Beek Smith Neshoba
date well completed firm name county well located

LANDOWNER: Garnell Daniels

description of formations encountered

from to

Route 2
Phila. Miss.
(mailing address)

red clay
blue chalk
gray sand
0 180
180 410
410 440

WELL LOCATION:

sec. 2 T 11 N R 13 E
S W
8 miles NE of Phila.
(distance) (direction) (nearest town)

WELL PURPOSE: home
(home, irrigation, municipal, industrial)

WELL COMPLETION DATA:

- (1) diameter (inches) 2"
- (2) total depth (feet) 440
- (3) static water level (feet) 100 ^{below} top of ground.
- (4) casing Galv. 157.
(material) (depth)
2" if telescope see back.
(size)
- (5) screen open well
(length) (depth to top)
(size) (material)
- (6) pump 1 HP
(HP) (yield gpm)
elec
(type power)
- (7) electric log NO
(yes or no)
(organization running log)
- (8) how well bottom plugged

CODED


APR 18 1969

DRILLERS REMARKS: Bottom open well

MISS. DD. OF
WATER

If well telescopes please sketch and show depths.

GROUND LEVEL

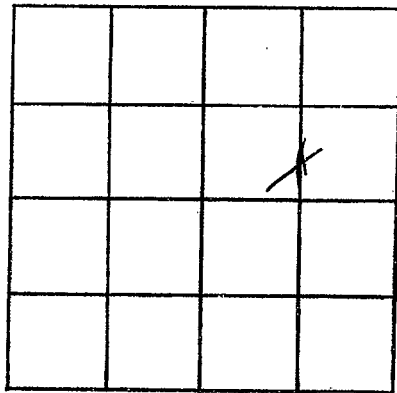

SECTION 2

Please indicate well location X.

ADDITIONAL INFORMATION

If more than one screen,
show locations of each on sketch.