

DH23 CODED 6 131

WATER WELL DRILLERS LOG

10-10-62

Date: 10-10, 1962 Driller: M J Ross County Neshoba

Ross E

(1) Owner of Land: Pet. Mc Donnell

(Name)

Phila miss Rt 2

(Address)

(2) Location: 1/4, 1/4, Sec. 22 11 13 T. R.

10 miles NE, of Phila. (distance) (direction) (Nearest Town)

(3) Topography: (Hilly) (Flat) (Level)

(4) Purpose of Well: Domestic Irrigation (Municipal, Industrial, Other)

Description & Color of Materials Sand, Clay, Red Clay, Shell, etc. Thickness Feet Depth Feet

Red sand to 15 ft yellow. Blue clay to 20 ft blue dirt to 125 ft Sand 125 X 145

Information upon completion of well:

(1) Diameter 2 inches.

(2) Total Depth 145 feet.

(3) Water Level 70 feet below top of ground.

(4) Cased to 92 ft, Size 2 in.

(5) Screen: Size, Length

(6) Were any formations sealed against pollution?


yes, no.

If YES depth of formation

Why

Drillers Remarks:

Casing sealed at 92 ft on pack

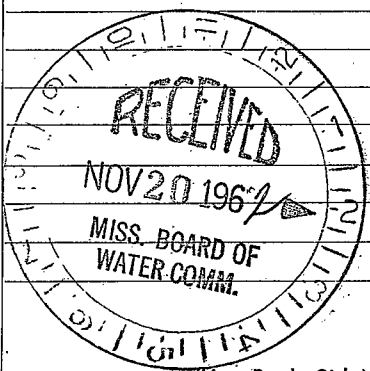

Well No.

