

Neshoba
 H 27
 2-12-70

MISSISSIPPI
 BOARD OF WATER COMMISSIONERS
 416 North State Street
 Jackson, Mississippi 39201

CODED

WATER WELL DRILLERS LOG

Neshoba

2-12-70 19 Agitation Drilling Co. Harrison
 date well completed firm name county well located

LANDOWNER:
Edmond Keikland
Box 2, P.O. Missal
 (mailing address)

description of formations encountered	from	to
Red clay	0	15
Red shales	15	170
Dray sands	170	215

WELL LOCATION:
 sec. 25 T 11 N S R 12 E W
 _____ miles _____ of _____
 (distance) (direction) (nearest town)

WELL PURPOSE: Normal
 (home, irrigation, municipal, industrial)

WELL COMPLETION DATA:
 (1) diameter (inches) 12 1/4
 (2) total depth (feet) 215
 (3) static water level (feet) 170 below/above top of ground.
 (4) casing Steel, 2 1/2 (material) (depth)
 _____ If telescope see back.
 (size)
 (5) screen 6', 9 1/2 - 210 (length) (depth to top)
1 1/2", Stainless Steel (size) (material)
 (6) pump 3/4 (HP) 11.5 (yield gpm)
R.P.A. (type power)
 (7) electric log NO (yes or no)
 _____ (organization running log)
 (8) how well bottom plugged Printed

CODED


MAY 1 1970

MISS. BD. OF WATER COMMISSIONERS

DRILLERS REMARKS:

If well telescopes please sketch and show depths.

GROUND LEVEL

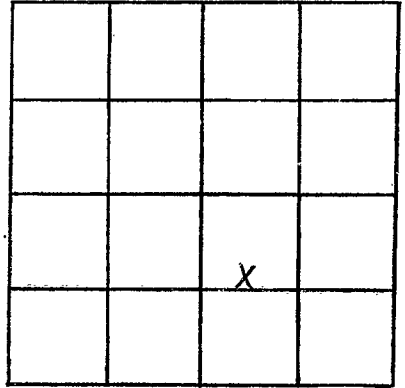

SECTION 25

Please indicate well location X.

ADDITIONAL INFORMATION

If more than one screen, show locations of each on sketch.