

NESHOBA
 H 30
 9-22-70

MISSISSIPPI
 BOARD OF WATER COMMISSIONERS
 416 North State Street
 Jackson, Mississippi 39201

CODED

WATER WELL DRILLERS LOG

date well completed 1970 firm name R. R. Richardson county well located Neshoba

LANDOWNER: Lawson Bell
R.R. Richardson
 (mailing address)

description of formations encountered	from	to
<u>blue chalk</u>	<u>0</u>	<u>20</u>
<u>white sand</u>	<u>20</u>	<u>75</u>
<u>water sand</u>	<u>75</u>	<u>97</u>
		<u>97</u>

WELL LOCATION:
 sec. 12 T. 11 N. R. 13 E
14 miles East of Phila
 (distance) (direction) (nearest town)

WELL PURPOSE:
 (home, irrigation, municipal, industrial)

- WELL COMPLETION DATA:
- (1) diameter (inches) 4
 - (2) total depth (feet) 97
 - (3) static water level (feet) 50 below above top of ground.
 - (4) casing steel 47
 (material) (depth)
 (size) if telescope see back.
 - (5) screen 10 97
 (length) (depth to top)
Johnson
 (size) (material)
 - (6) pump 1/2 26
 (HP) (yield gpm)
R.I.M.
 (type power)
 - (7) electric log
 (yes or no)

 (organization running log)
 - (8) how well bottom plugged

CODED

DEC 15 1970


MISS. BD. OF
 WATER COMM.

DRILLERS REMARKS:

If well telescopes please
sketch and show depths.

GROUND LEVEL

Hilly

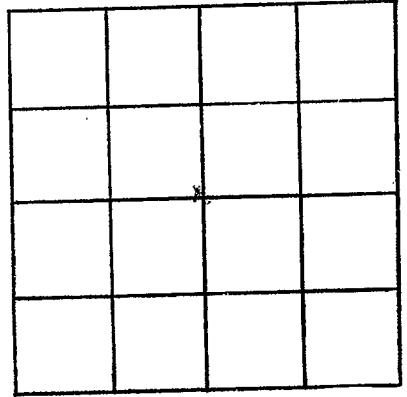

SECTION _____

Please indicate well location X.

ADDITIONAL INFORMATION

If more than one screen,
show locations of each on sketch.