

H 34

4-18-61

WATER WELL DRILLERS LOG

CODED

Date: 4-18, 1961, Driller: R R Nicholson, County Weshoba

BC-9 Steve Thompson (Name)

| | Description & Color of Materials Sand, Clay, Red Clay, Shell, etc. | Thick- ness Feet | Depth Feet |
|---|---|------------------------|---------------|
| (1) Owner of Land: <u>V. B. Scott</u> <u>Phila. Miss</u> (Name) (Address) | <u>Clear Sand</u> | <u>100</u> | <u>28</u> |
| | <u>Black dirt</u> | <u>28</u> | <u>80</u> |
| (2) Location: $\frac{1}{4}$, <u>2, 11, 13</u> Sec. <u>T, R</u> | <u>Black dirt</u> | <u>90</u> | <u>90</u> |
| <u>15</u> miles <u>East</u> of <u>Phila</u> (distance) (direction) (Nearest Town) | <u>Water Sand</u> | <u>90</u> | <u>106</u> |
| (3) Topography: <u>Hilly</u> (Hilly) (Flat) (Level) | | | |
| (4) Purpose of Well: <u>Domestic</u> (Domestic Irrigation Municipal, Industrial, Other) | | | |

CODED

Information upon completion of well:


- (1) Diameter 3 7/8 inches.
- (2) Total Depth 106 feet.
- (3) Water Level 70 feet below top of ground.
- (4) Cased to Bottom, Size 7 in.
- (5) Screen: Size 1 1/4, Length 10 ft.
- (6) Were any formations sealed against pollution?

yes, no.

If YES depth of formation 31 ft 4" pipe

Why Sanitary purposes

Drillers Remarks: very fine water sand
84 ft to cylinder

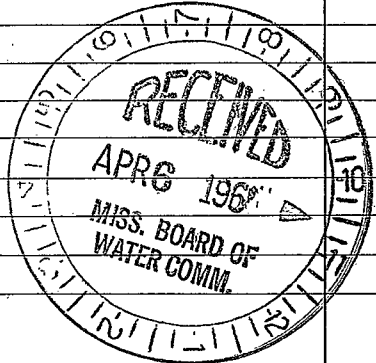

(Use Back Side)

Well No.

Handwritten notes at the top of the page, including a large number '10' and some illegible scribbles.

Handwritten notes in the middle section, appearing as faint, scattered characters and lines.

Handwritten notes at the bottom of the page, including a large number '10' and some illegible scribbles.