

NEHOBA MISSISSIPPI BOARD OF WATER COMMISSIONERS

H37

4-20-61

WATER WELL DRILLERS LOG

CODED

Date: 4-30, 1961, Driller: R.R. Nicholson, County: Nehoba

AL-6 Tom Bell (Name)

(1) Owner of Land: V.B. Grant  
 Phila. Miss.  
 (Name)  
 (Address)

(2) Location: 1/4, 3 11 13, Sec. T<sub>2</sub> R  
 15 miles east of Phila.  
 (distance) (direction) (Nearest Town)

(3) Topography: Hilly  
 (Hilly) (Flat) (Level)

(4) Purpose of Well: Domestic  
 (Domestic Irrigation  
 Municipal, Industrial, Other)

Description & Color of Materials Sand, Clay, Red Clay, Shell, etc.	Thick- ness Feet	Depth Feet
Clear sand	1	18
Shell rocks	18	22
Yellow dirt	22	55
Water dirt	55	70
Water sand	70	84

CODED

Information upon completion of well:

(1) Diameter 3 7/8 inches.

(2) Total Depth 84 feet.

(3) Water Level 50 feet below top of ground.

(4) Cased to bottom, Size 2"


(5) Screen: Size 1 1/4, Length 10 ft.

(6) Were any formations sealed against pollution?  
 X yes, no.

If YES depth of formation 21 ft 4 in. pipe

Why Sanitary Purpose

Drillers Remarks: Pure sand  
 63 ft to cylinder

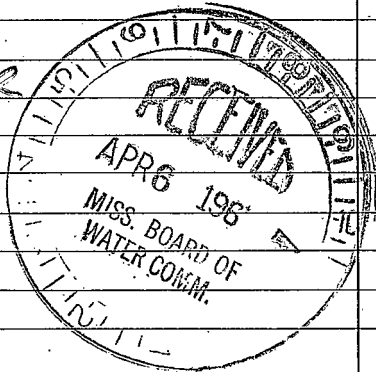

(Use Back Side)

Well No.

Handwritten notes at the top of the page, including a date "1954" and some illegible scribbles.

Vertical handwritten notes on the left side of the page.

Handwritten notes in the upper middle section of the page.

Large handwritten notes in the middle section of the page, including a date "June 27" and other illegible text.

Handwritten notes in the lower middle section of the page, including a date "July 1" and other illegible text.

Large handwritten notes at the bottom of the page, including a date "July 1" and other illegible text.