

NEHOBA

MISSISSIPPI BOARD OF WATER COMMISSIONERS

H 38

5-3-61

WATER WELL DRILLERS LOG

CODED

Date: 5-3, 1961, Driller: R.R. Nicholson County Nechaha

15-4 Fine Thompson

(1) Owner of Land: W.S. Gant
Rhila, Miss.
(Name)
(Address) 21113

(2) Location: 1/4, 1/4, Sec. T R
15 miles east of Rhila.
(distance) (direction) (Nearest Town)

(3) Topography: Hilly
(Hilly) (Flat) (Level)

(4) Purpose of Well: Domestic
(Domestic Irrigation
Municipal, Industrial, Other)

Description & Color of Materials Sand, Clay, Red Clay, Shell, etc.	Thick- ness Feet	Depth Feet
Clay & Sand	1	30
Coarse Sand	30	90
Red Clay	90	125
Red Clay	725	135
Water Sand	135	250


CODED

Information upon completion of well:

- (1) Diameter 3 7/8 inches.
- (2) Total Depth 250 feet.
- (3) Water Level 150 feet below top of ground.
- (4) Cased to Bottom, Size 2"
- (5) Screen: Size 1/4, Length 10 ft.
- (6) Were any formations sealed against pollution?

X yes, no.

If YES depth of formation 21 ft 4" pipe
Why Sanitary Purpose
Drillers Remarks: coarse sand

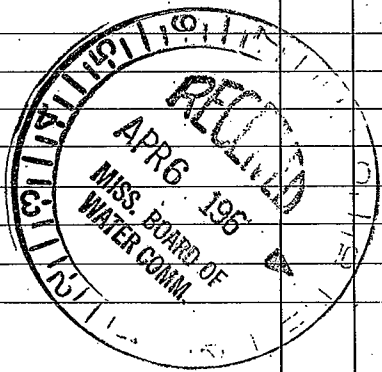

(Use Back Side)

Well No.

Handwritten notes at the top of the page, including the word "Molecular" and some illegible scribbles.

Handwritten notes in the middle section, appearing as a list or series of points, though the text is mostly illegible.

Handwritten notes at the bottom of the first section, possibly including a signature or date.

Handwritten notes in the second section, including a vertical list of items on the right side.

Handwritten notes at the bottom of the page, including a signature and some illegible text.