

H 39  
4-27-61

WATER WELL DRILLERS LOG

CODED

Date: 4-27, 1961, Driller: B.R. Nicholson County: Neshoba  
B.R.-3 Mick Henry (Name)

(1) Owner of Land: V.B. Hunt  
Phila. Miss. (Name)  
(Address)

(2) Location: 1/4, 2 11 13, Sec. T R  
15 miles East, of Phila. (distance), (direction), (Nearest Town)

(3) Topography: Hilly (Hilly), (Flat), (Level)

(4) Purpose of Well: Domestic (Domestic Irrigation, Municipal, Industrial, Other)

Description & Color of Materials Sand, Clay, Red Clay, Shell, etc.

Thick-ness Feet

Depth Feet

1-20	1	20
20-25	20	25
25-50	35	50
50-60	50	60

CODED

Information upon completion of well:


- (1) Diameter 2 7/8 inches.
- (2) Total Depth 60 feet.
- (3) Water Level 28 feet below top of ground.
- (4) Cased to bottom, Size 2"
- (5) Screen: Size 1/4, Length 10ft.
- (6) Were any formations sealed against pollution?

yes, no.

If YES depth of formation 21ft 4" Pipe

Why: Secondary Surface

Drillers Remarks: Fine Sand  
4 2 ft in Cylinder

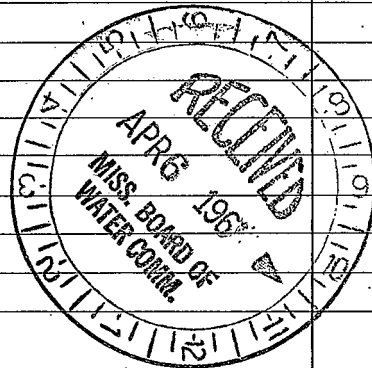

(Use Back Side)

Well No.

10/10/50

10/10/50

10

10-30

10/10/50

10/10/50

