

H40

WATER WELL DRILLERS LOG

CODED

5-29-61

Date: 5-29, 1961, Driller: RR Nichols County Neshoba

BC-1 Gowen H. Thompson (Name)

(1) Owner of Land: W S Grant
 (Name)
Phila. Miss.
 (Address)

(2) Location: 2 11 13
 1/4, 1/4, Sec. T R
15 miles east of Phila
 (distance) (direction) (Nearest Town)

(3) Topography: Hilly
 (Hilly) (Flat) (Level)

(4) Purpose of Well: Domestic
 (Domestic Irrigation
 Municipal, Industrial, Other)

Description & Color of Materials Sand, Clay, Red Clay, Shell, etc.	Thick- ness Feet	Depth Feet
<u>Chalk & Sand</u>	<u>1</u>	<u>18</u>
<u>Blue dirt</u>	<u>18</u>	<u>40</u>
<u>Black dirt</u>	<u>40</u>	<u>80</u>
<u>Sand & dirt</u>	<u>20</u>	<u>90</u>
<u>Blue dirt</u>	<u>90</u>	<u>135</u>
<u>Water sand</u>	<u>135</u>	<u>150</u>

Information upon completion of well:

(1) Diameter 3 7/8 inches.

(2) Total Depth 150 feet.

(3) Water Level 90 feet below top of ground.

(4) Cased to Bottom Size 2'


(5) Screen: Size 1/4, Length 10'

(6) Were any formations sealed against pollution?
 yes, no.

If YES depth of formation 2' of U Pipe
 Why Sanitary Purpose

Drillers Remarks: Line water sand
105 ft to cylinder

CODED

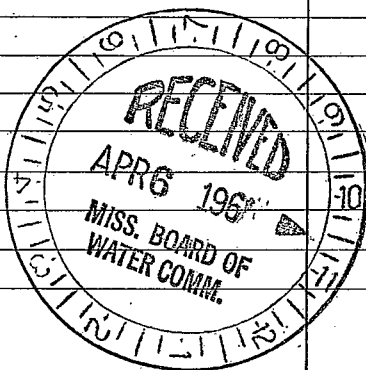

(Use Back Side)

Well No.

Handwritten notes, possibly a list or journal entries, covering the top half of the page. The text is very faint and difficult to decipher.

Handwritten notes on the right side of the page, including the word "Café" and other illegible characters.

Handwritten notes at the bottom of the page, including the word "Café" and other illegible characters.