

H 41

WATER WELL DRILLERS LOG

CODED

5-10-61

Date: 5-10, 1961, Driller: R R Nicholas County Nechaha
BC-13 Dempsey name

(1) Owner of Land: V. S. Hunt
(Name)
Phila. Miss.
(Address)

(2) Location: 1/4, 2, 11 13
Sec. 11 13
15 miles East of Phila
(distance) (direction) (Nearest Town)

(3) Topography: Hilly
(Hilly) (Flat) (Level)

(4) Purpose of Well: Domestic
(Domestic Irrigation
Municipal, Industrial, Other)

Description & Color of Materials (Sand) Clay, Red Clay, Shell, etc.	Thick- ness Feet	Depth Feet
<u>Chalk</u>	<u>1</u>	<u>20</u>
<u>Black dirt</u>	<u>20</u>	<u>30</u>
<u>Shale dirt</u>	<u>30</u>	<u>60</u>
<u>Black dirt</u>	<u>60</u>	<u>80</u>
<u>Find Water Sand</u>	<u>80</u>	<u>100</u>

CODED

Information upon completion of well:

(1) Diameter 3 7/8 inches.

(2) Total Depth 100 feet.

(3) Water Level 65 feet below top of ground.

(4) Cased to Bottom, Size 2"


(5) Screen: Size 1 1/4, Length 10'

(6) Were any formations sealed against pollution?
X yes, _____ no.

If YES depth of formation 21 ft 4" pipe

Why Sanitary Purpose

Drillers Remarks: Very fine
8 7 ft to Cylinder

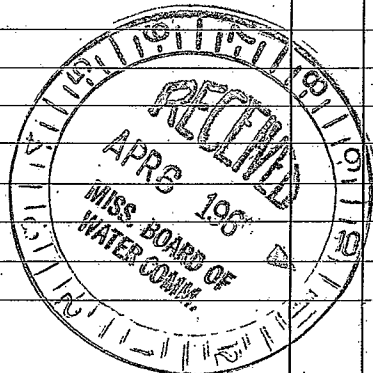

Well No.

(Use Back Side)

Handwritten text at the top of the page, possibly a header or title, including the number "13" and "21-26".

Handwritten notes on the left side of the page, appearing as a list or series of entries.

Handwritten notes on the right side of the page, including the word "probit" and other illegible text.

Vertical handwritten text on the right side of the page, possibly a date or a specific label.

Handwritten text at the bottom of the page, possibly a signature or a concluding note.