

NESHOBA

H42

5-9-61

WATER WELL DRILLERS LOG

CODED

Date: 5-9, 1961, Driller: R.B. Nicholas, County Neshoba
B.C. - 13 Bob Henry (Name)

(1) Owner of Land: V.B. Gault
(Name)
Phila. Miss.
(Address)

(2) Location: 2 1/4 miles, 2 Sec. 13 T. R.
(distance) (direction) (Nearest Town)

(3) Topography: Hilly
(Hilly) (Flat) (Level)

(4) Purpose of Well: Domestic
(Domestic Irrigation, Municipal, Industrial, Other)

Description & Color of Materials Sandy Clay, Red Clay, Shell, etc.	Thick- ness Feet	Depth Feet
<u>Chalk</u>	<u>1</u>	<u>18</u>
<u>blue dirt</u>	<u>18</u>	<u>40</u>
<u>Black dirt</u>	<u>40</u>	<u>150</u>
<u>White dirt</u>	<u>150</u>	<u>160</u>
<u>Mil sand dirt</u>	<u>160</u>	<u>205</u>
<u>water</u>	<u>205</u>	<u>220</u>

CODED

Information upon completion of well:

(1) Diameter 3 7/8 inches.

(2) Total Depth 220 feet.

(3) Water Level 140 feet below top of ground.

(4) Cased to bottom, Size 2"


(5) Screen: Size 1/4, Length 10ft

(6) Were any formations sealed against pollution?
X yes, no.

If YES depth of formation 21 ft 4" Pipe

Why for sanitary purpose

Drillers Remarks: Very fine sand
it is 160 ft to
Cylinder

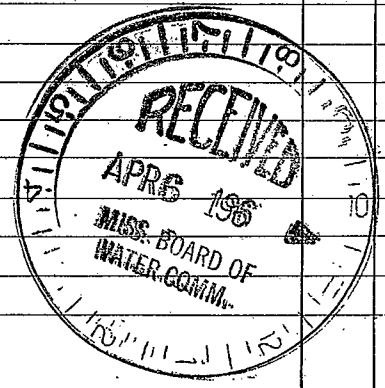

(Use Back Side)

Well No.

Handwritten notes at the top of the page, possibly including a date or title.

Handwritten notes in the upper middle section, appearing as a list or series of entries.

Handwritten notes in the middle section, possibly a sub-section or a specific entry.

Handwritten notes in the lower middle section, including some numbers and possibly a small diagram or list.

Handwritten notes at the bottom of the page, possibly concluding the text or providing a summary.