

H43

5-5-61

WATER WELL DRILLERS LOG **CODED**

Date: 5-5, 1961, Driller: R.R. Nicholson County Neshoba
B.C.-11 Sallie Hansen (Name)

- (1) Owner of Land: W.B. Smith
 (Name)
Phila. Miss.
 (Address)
- (2) Location: 2 11 13
 1/4, 1/4, Sec. T R
15 miles East of Phila.
 (distance) (direction) (Nearest Town)
- (3) Topography: Hilly
 (Hilly) (Flat) (Level)
- (4) Purpose of Well: Domestic
 (Domestic Irrigation
 Municipal, Industrial, Other)


| Description & Color of Materials Sand, Clay, Red Clay, Shell, etc. | Thick- ness Feet | Depth Feet |
|---|------------------------|---------------|
| <u>Clear Choke</u> | <u>1</u> | <u>18</u> |
| <u>Shell rock</u> | <u>18</u> | <u>20</u> |
| <u>Blue dirt</u> | <u>20</u> | <u>160</u> |
| <u>Black dirt</u> | <u>160</u> | <u>180</u> |
| <u>Mix. Sand & dirt</u> | <u>180</u> | <u>250</u> |
| <u>Water</u> | <u>250</u> | <u>262</u> |

CODED

Information upon completion of well:

- (1) Diameter 3 1/8 inches.
- (2) Total Depth 262 feet.
- (3) Water Level 170 feet below top of ground.
- (4) Cased to Bottom, Size 2"
- (5) Screen: Size 1 1/4, Length 10ft
- (6) Were any formations sealed against pollution?
 yes, no.

If YES depth of formation 19ft 4" pipe
 Why Sanitary Purpose
 Drillers Remarks: Case Sand
190 ft. to cylinder

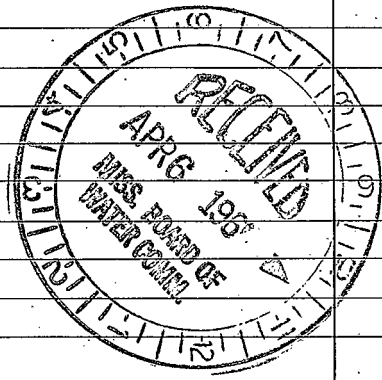

(Use Back Side)

Well No.

Handwritten notes at the top of the page, including the number "11" and "11-5-53".

Vertical handwritten notes on the left side of the page.

Handwritten notes in the middle-left section of the page.

Handwritten notes in the middle-right section of the page.

Vertical handwritten notes on the right side of the page.

Handwritten notes at the bottom of the page.