

H44

WATER WELL DRILLERS LOG

CODED

5-26-61

Date: 5-26, 1961, Driller: P R Nicholas County Neshoba  
BC 2 Fannie Thompson

(1) Owner of Land: V.S. Gort  
(Name)  
Shila - Miss.  
(Address)

(2) Location: 2 11 13  
1/4, 1/4, Sec. T R  
15 miles east of Shila  
(distance) (direction) (Nearest Town)

(3) Topography: Hilly  
(Hilly) (Flat) (Level)

(4) Purpose of Well: Domestic  
(Domestic Irrigation  
Municipal, Industrial, Other)

Description & Color of Materials Sand, Clay, Red Clay, Shell, etc.	Thick- ness Feet	Depth Feet
Chalk & Clay	1	20
bluedirt & rock	20	30
blue dirt	30	80
Rock	80	82
mix bluedirt & sand	82	120
water sand	120	137

Information upon completion of well:

(1) Diameter 3 7/8 inches.

(2) Total Depth 137 feet.

(3) Water Level 80 feet below top of ground.

(4) Cased to bottom, Size 2"

(5) Screen: Size 1 1/4, Length 10'


(6) Were any formations sealed against pollution?  
 yes,  no.

CODED

If YES depth of formation 21 ft 4" pipe

Why Sanitary Purpose

Drillers Remarks: fine sand  
90 ft to cylinder

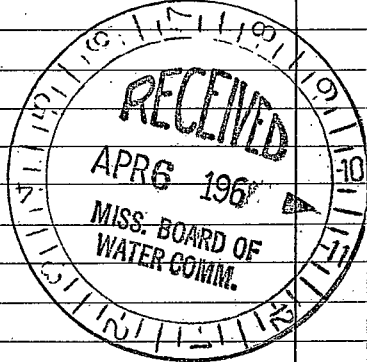

Well No.

(Use Back Side)

Handwritten notes at the top of the page, including the word "Solutions" and other illegible text.

Main body of handwritten notes, including a list of numbers (1, 2, 3, 4, 49, 50) and other illegible text.