

H95

WATER WELL DRILLERS LOG

CODED

5-31-61

Date: 5-31, 1961, Driller: B.R. Nicholson, County: Neshoba

BC-22-Trustee Bull

(1) Owner of Land: U.S. Boyd
(Name)
Phila Miss.
(Address)

(2) Location: 1/4, 7 1/4, Sec. 11 13
T R
16 miles East of Phila.
(distance) (direction) (Nearest Town)

(3) Topography: Hills
(Hilly) (Flat) (Level)

(4) Purpose of Well: Domestic
(Domestic Irrigation
Municipal, Industrial, Other)

Description & Color of Materials
Sand, Clay, Red Clay, Shell, etc.

Thick-
ness
Feet

Depth
Feet

Chalk & sand	1	17
black dirt	17	40
blue dirt	40	90
water sand	90	106

CODED

Information upon completion of well:

(1) Diameter 3 7/8 inches.

(2) Total Depth 106 feet.

(3) Water Level 60 feet below top of ground.

(4) Cased to bottom, Size 2"


(5) Screen: Size 1 1/4", Length 10'

(6) Were any formations sealed against pollution?
yes, no.

If YES depth of formation 21 ft 4" pipe

Why Sanitary Purpose

Drillers Remarks: Pink Sand
74 ft to cylinders

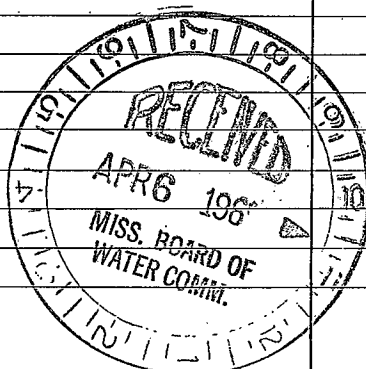

(Use Back Side)

Well No.

1900

Received of Mr. J. H. ...

the sum of ...

for ...

...

...

