

Neshoba  
H47  
7-22-71

MISSISSIPPI  
BOARD OF WATER COMMISSIONERS  
416 North State Street  
Jackson, Mississippi 39201

**CODED**

WATER WELL DRILLERS LOG

7-22 1971 Bob. Nicholson Neshoba  
date well completed firm name county well located

LANDOWNER: Rose Jones  
Phila -  
Miss.  
(mailing address)

description of formations encountered	from	to
Clay	0	20
Chalk & dirt	20	60
fine sand & dirt	60	105
water sand	105	118

WELL LOCATION:  
sec. 28 T 11 N R 13 E  
(distance) (direction) (nearest town)

WELL PURPOSE: home  
(home, irrigation, municipal, industrial)

- WELL COMPLETION DATA:
- (1) diameter (inches) 4 1/4
  - (2) total depth (feet) 118
  - (3) static water level (feet) 70 below above top of ground.
  - (4) casing galv. 113'  
(material) (depth)  
2"  
(size) If telescope see back.
  - (5) screen 5- 118'  
(length) (depth to top)  
1 1/4" steel  
(size) (material)
  - (6) pump 1 8  
(HP) (yield gpm)  
elect  
(type power)
  - (7) electric log no  
(yes or no)
  - (8) how well bottom plugged \_\_\_\_\_  
(organization running log)

**CODED**


DRILLERS REMARKS:

NOV 10 1971  
NOV 10 1971

MISS. BO. OF  
WATER

If well telescopes please sketch and show depths.

GROUND LEVEL

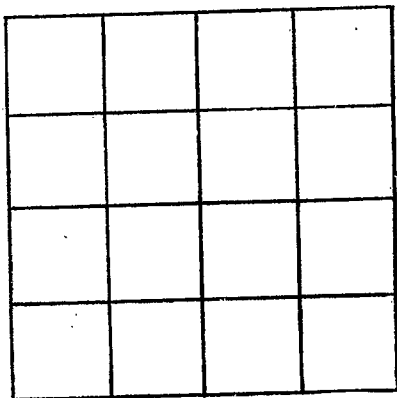

SECTION \_\_\_\_\_

Please indicate well location X.

ADDITIONAL INFORMATION

If more than one screen, show locations of each on sketch.