

NESHOBA
 H37155
 5-26-81
 Elog #36

MISSISSIPPI
 BOARD OF WATER COMMISSIONERS
 416 North State Street
 Jackson, Mississippi 39201

CODED

WATER WELL DRILLERS LOG

5-26-81 1981 T.M. PARKS DRILL CO. NESHOBA
 date well completed firm name county well located


LANDOWNER: CENTRAL
 WATER ASSOCIATION (EASTSIDE)
 NESHOBA COUNTY, MS.
 (mailing address)

WELL LOCATION:
 sec. 17 T 11 N R 13 E W
 (distance) (direction) (nearest town)

WELL PURPOSE: CITY WELL
 (home, irrigation, municipal, industrial)

WELL COMPLETION DATA:
 (1) diameter (inches) 10"
 (2) total depth (feet) 685'
 (3) static water level (feet) _____ below/above top of ground.
 (4) casing U.S. steel 609' (material) (depth)
 10" (size) if telescope see back.
 (5) screen 60' (length) (depth to top)
 6" stainless steel (size) (material)
 (6) pump 40 300 (HP) (yield gpm)
 3 phase (type power)
 (7) electric log yes (yes or no)
 MGS (organization running log)
 (8) how well bottom plugged BPV

description of formations encountered	from	to
TOPSOIL	0	30
CLAYS/LIMESTONE	30	125
SAND	125	170
SHALES -LIMESTONE- CHALK	170	510
SAND, fine grey W/ SHALES	510	560
GUMBO	560	590
SAND	590	600
GUMBO	600	608
MASSIVE SAND	608	685

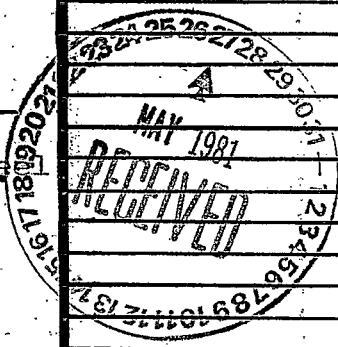

DRILLERS REMARKS:

If well telescopes please sketch and show depths.

GROUND LEVEL

SECTION _____

Please indicate well location X.

ADDITIONAL INFORMATION

If more than one screen, show locations of each on sketch.