

WESTHUBA
H 2000
5/11/81
5-11

MISSISSIPPI
BOARD OF WATER COMMISSIONERS
416 North State Street
Jackson, Mississippi 39201

WATER WELL DRILLERS LOG

date well completed 1981 firm name *Concord Drilling Service* county well located *Westhoba*

LANDOWNER: *Bill Richardson*
Union Rites MS
(mailing address)

WELL LOCATION:
sec. 6 T. 11 N R. 13 E
7 miles NE Subotopol
(distance) (direction) (nearest town)

WELL PURPOSE: *irrigation*
(home, irrigation, municipal, industrial)

WELL COMPLETION DATA:
(1) diameter (inches) 4"
(2) total depth (feet) 200
(3) static water level (feet) 90 below above top of ground.
(4) casing PVC 120
(material) (depth)
(size) If telescope see back.
(5) screen _____
(length) (depth to top)
(size) (material)
(6) pump 3W 15
(HP) (yield gpm)
E
(type power)
(7) electric log No
(yes or no)
(organization running log)

(8) how well bottom plugged *Open*

DRILLERS REMARKS:


description of formations encountered	from	to
<i>Clay</i>	<i>0</i>	<i>10</i>
<i>Sand</i>	<i>10</i>	<i>60</i>
<i>Clay</i>	<i>60</i>	<i>120</i>
<i>Shells to sand & Clay</i>	<i>120</i>	<i>160</i>
<i>Gravel Sand</i>	<i>160</i>	<i>200</i>

DEPT. OF NATURAL RESOURCES
BUREAU OF LAND & WATER RESOURCES

MAY 19 1981
RECEIVED

If well telescopes please
sketch and show depths.

GROUND LEVEL

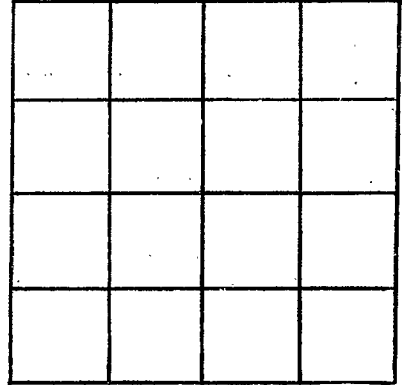

SECTION _____

Please indicate well location X.

ADDITIONAL INFORMATION

If more than one screen,
show locations of each on sketch.