

MISSISSIPPI DEPARTMENT OF NATURAL RESOURCES

Bureau of Land and Water Resources

Southport Mall

P.O. Box 10631

Jackson, Mississippi 39209

WATER WELL DRILLERS LOG

Neshoba
H 2001
9-28-81

9-28-81 19 McDonald Hill Neshoba
 date well completed firm name county well located

LANDOWNER:

Charter Health Center
Box R-50 Philadelphia
 (mailing address)

description of formations encountered

from to

WELL LOCATION:

sec. 15 T. 11 N. R. 13 E
10 miles NE of Philadelphia
 (distance) (direction) (nearest town)

clay 0 20

in sand 20 26

shale & lignite 26 30

Med sand 30 103

shale 103 122

WELL PURPOSE: none
 (home, irrigation, municipal, industrial)

shale & fine sand 122 140

WELL COMPLETION DATA:

sand 140 160

sandy shale 160 180

shale & fine sand 180 200

sandy shale & lignite 200 213

shale & lignite 213 270

shale & fine sand 278 300

sand

(1) diameter (inches) 4"

(2) total depth (feet) 300'

(3) static water level (feet) 30' below top of ground.

(4) casing PVC 150'
 (material) (depth)

4" if telescope see back.
 (size)

(5) screen 10 150' to 160'
 (length) (depth to top)

4" PVC
 (size) (material)

(6) pump 1/2 800
 (HP) (yield gpm)

E
 (type power)

(7) electric log —
 (yes or no)

(organization running log)


(8) how well bottom plugged value

DRILLERS REMARKS:

DEPT. OF NATURAL RESOURCES
 BUREAU OF LAND & WATER RESOURCES
 OCT - 5 1981
RECEIVED

If well telescopes please sketch and show depths.

GROUND LEVEL

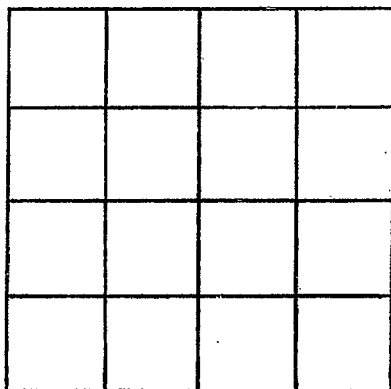

SECTION _____

Please indicate well location X.

ADDITIONAL INFORMATION

81 Oct 5 10:50

RECEIVED

If more than one screen, show locations of each on sketch.