

**MISSISSIPPI DEPARTMENT OF ENVIRONMENTAL QUALITY**

Office of Land and Water Resources

P. O. Box 10631  
Jackson, MS 39289-0631

**WATER WELL DRILLERS LOG**

COUNTY WELL LOCATED <b>Neshoba</b>	
WELL NUMBER <b>A 2006</b>	CODED
DATE WELL COMPLETED <b>2-5-00</b>	

PERMIT NUMBER
NAME OF DRILLING FIRM <b>PARKS + PARKS WATERWELL SER</b>

NAME & MAILING ADDRESS OF LANDOWNER <b>Jim WHITE</b>		
<b>11591 CR 743</b>		
<b>Philadelphia, MS 39350</b>		
WELL LOCATION: SEC	TOWNSHIP	RANGE
<b>7</b>	<b>11</b>	<b>13</b>
	<b>(N)</b>	<b>(E)</b>
	<b>(S)</b>	<b>(W)</b>
DISTANCE	DIRECTION	NEAREST TOWN
_____ Miles	_____ of	_____
OTHER LANDMARK		
WELL PURPOSE: Home, Irrigation, Municipal, Industrial, Fish Pond, etc. <b>Chicken Farm</b>		

PUMP DATA		
PUMP TYPE (Circle One): <b>Submersible</b> , Turbine, Jet, Flowing Well, Other (Describe) _____		
POWER TYPE (Circle One): <b>Electric</b> , Tractor, Diesel, Gasoline, Butane, Other (Describe) _____ H/P <b>2</b>		
Pump Capacity (GPM) <b>20</b>	No. of Stages	Setting Depth <b>168</b> FT.
PUMP TEST		
Well yielded _____ GPM with a drawdown of _____ ft. after _____ hours of pumping		

WELL DATA		
Well Depth <b>63</b>	Casing Diameter (In.) <b>4</b>	Casing Length (Ft.) <b>595</b>
Type of Casing <b>STEEL</b>	Hole Depth <b>640</b>	Depth to Static Water Level

LOG DATA	
TYPE OF LOG RUN (Circle One): Electric, Gamma Ray, Density, Sonic, Neutron, Other (Describe) _____ <b>No Log Run</b>	
Name of Organization Running Log	

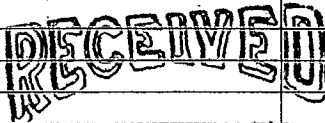
TYPE OF COMPLETION: (Circle One or More): <b>Gravel Packed</b> , Underreamed, Telescoped, Natural Development, Open Hole, Other (Describe) _____			
---	--	--	--

WELL GROUTED TO A DEPTH OF <b>500</b> FEET Type Grout (circle one): Cement, Bentonite, or <b>Mix</b>
---

GEOLOGIC DATA (Office Use Only)			
Surface Elev.	Geologic Unit	Unit Thickness	Depth to Top
Subs. SWL	Date	Analysis	Aquifer Test

SCREEN DATA		
Diameter - Inches <b>4</b>	Length - Feet <b>40</b>	Slot Size - Inches <b>.010</b>
Screen Type <b>SS</b>	Depth to Bottom - Feet <b>635</b>	

Driller's Remarks

DESCRIPTION OF FORMATIONS ENCOUNTERED	FROM	TO	FORMATIONS (Continued)	FROM	TO
<b>CLAY</b>	<b>0</b>	<b>340</b>	 <b>JUN 12 2001</b> Dept. of Environmental Quality Office of Land & Water Resources		
<b>CLAY + SAND</b>	<b>340</b>	<b>450</b>			
<b>SAND</b>	<b>450</b>	<b>520</b>			
<b>CLAY SAND</b>	<b>520</b>	<b>580</b>			
<b>SAND</b>	<b>580</b>	<b>635</b>			
<b>CLAY</b>	<b>635</b>	<b>640</b>			

IF MORE SPACE IS NEEDED, USE BACK

