

MISSISSIPPI DEPARTMENT OF ENVIRONMENTAL QUALITY

Office of Land and Water Resources

P. O. Box 10631

Jackson, MS 39289-0631

WATER WELL DRILLERS LOG

COUNTY WELL LOCATED NESHOBBA	
WELL NUMBER H 2008	CODED
DATE WELL COMPLETED	

PERMIT NUMBER
NAME OF DRILLING FIRM PARKS + PARKS WELL SERVICE

NAME & MAILING ADDRESS OF LANDOWNER CHUCK MARSHALL		
10340 CR 646		
Philadelphia, MS 39350		
WELL LOCATION: SEC	TOWNSHIP	RANGE
13	11	15
	N	E
	S	W
DISTANCE	DIRECTION	NEAREST TOWN
_____ Miles	_____ of _____	_____
OTHER LANDMARK		
WELL PURPOSE: Home, Irrigation, Municipal, Industrial, Fish Pond, etc. CHICKEN FARM		

PUMP DATA		
PUMP TYPE (Circle One): <input checked="" type="radio"/> Submersible, Turbine, Jet, Flowing Well, Other (Describe) _____		
POWER TYPE (Circle One): <input checked="" type="radio"/> Electric, Tractor, Diesel, Gasoline, Butane, Other (Describe) _____ H/P 2		
Pump Capacity (GPM) 20	No. of Stages	Setting Depth 168 FT.
PUMP TEST		
Well yielded _____ GPM with a drawdown of _____ ft. after _____ hours of pumping		

WELL DATA		
Well Depth 360	Casing Diameter (In.) 4	Casing Length (Ft.) 320
Type of Casing PVC	Hole Depth 360	Depth to Static Water Level

LOG DATA	
TYPE OF LOG RUN (Circle One): Electric, Gamma Ray, Density, Sonic, Neutron, Other (Describe) _____	
<input checked="" type="radio"/> No Log Run	
Name of Organization Running Log	

TYPE OF COMPLETION: (Circle One or More): <input checked="" type="radio"/> Gravel Packed, Underreamed, Telescoped, Natural Development, Open Hole, Other (Describe) _____		
--	--	--

GEOLOGIC DATA (Office Use Only)			
Surface Elev.	Geologic Unit	Unit Thickness	Depth to Top
Subs. SWL	Date	Analysis	Aquifer Test

WELL GROUTED TO A DEPTH OF 270 FEET Type Grout (circle one): Cement, Bentonite, <input checked="" type="radio"/> or Mix

Driller's Remarks


SCREEN DATA		
Diameter - Inches 4	Length - Feet 40	Slot Size - Inches .010
Screen Type PVC	Depth to Bottom - Feet 360	

DESCRIPTION OF FORMATIONS ENCOUNTERED	FROM	TO	FORMATIONS (Continued)	FROM	TO
CLAY	0	155	RECEIVED JUN 1 2 2001		
SAND + CLAY	155	220			
CLAY	220	240			
SAND + CLAY	240	275			
SAND	275	360			

Dept. of Environmental Quality
Office of Land & Water Resources

IF MORE SPACE IS NEEDED, USE BACK

If well telescopes please
sketch and show depths.

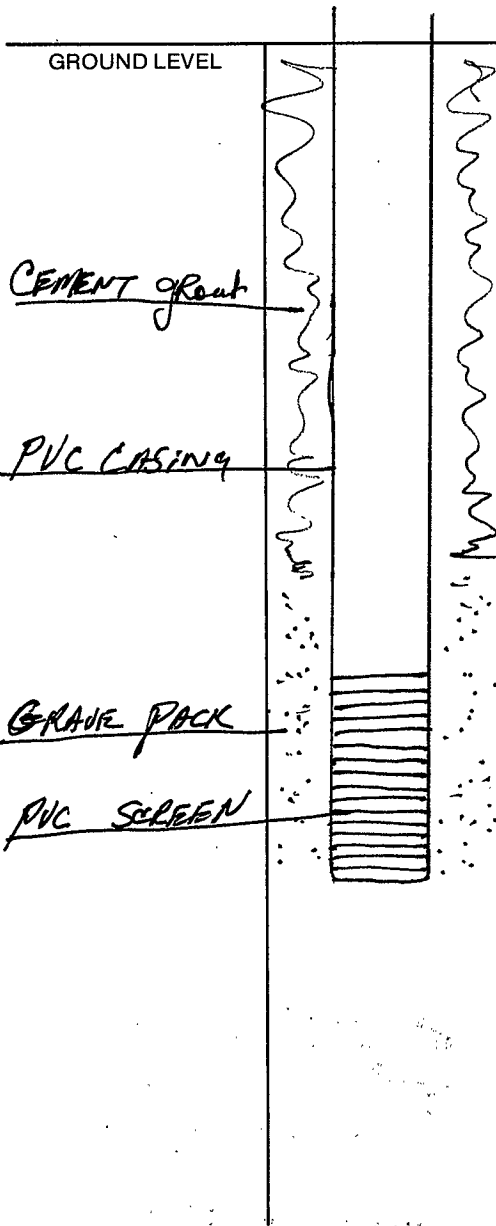

SECTION _____

Please indicate well location X.

ADDITIONAL INFORMATION

If more than one screen,
show location of each on sketch.