

5 13T

MISSISSIPPI
BOARD OF WATER COMMISSIONERS
416 North State Street
Jackson, Mississippi 39201

WATER WELL DRILLERS LOG

Neshoba
K J I CODED
1-68

1-17 1968 P.R. Nicholson Neshoba
 date well completed firm name county well located

LANDOWNER: C. L. Payne
Rt 5
Shila, Miss.
 (mailing address)

description of formations encountered	from	to
Clay	0	11
Clay & sand	11	39
Chalk	39	43
Water Sand	43	56

WELL LOCATION:
 sec. 13 T 10 N R 10 E
8 miles west of Shila
 (distance) (direction) (nearest town)

WELL PURPOSE: Home
 (home, irrigation, municipal, industrial)

- WELL COMPLETION DATA:
- (1) diameter (inches) 4"
 - (2) total depth (feet) 56"
 - (3) static water level (feet) 43 below above top of ground.
 - (4) casing Galv., 4 1/2"
 (material) (depth)
2" if telescope see back.
 (size)
 - (5) screen 5', 56
 (length) (depth to top)
1 1/4" Steel
 (size) (material)
 - (6) pump 1/2 6
 (HP) (yield gpm)
Eliot
 (type power)
 - (7) electric log No
 (yes or no)
 (organization running log)
 - (8) how well bottom plugged

DRILLERS REMARKS:

MAY 14 1968

CODED

MISSISSIPPI BOARD OF WATER COMMISSIONERS


RECEIVED

FEB 23 1968

MISS. BOARD OF WATER COMMISSIONERS

If well telescopes please sketch and show depths.

GROUND LEVEL

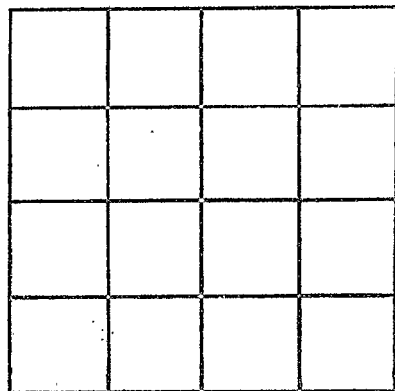

SECTION _____

Please indicate well location X.

ADDITIONAL INFORMATION

If more than one screen,
show locations of each on sketch.