

5

13T

0

724120N0891840

CODED
TESS

Neshoba
J4
10-17-68

MISSISSIPPI
BOARD OF WATER COMMISSIONERS
416 North State Street
Jackson, Mississippi 39201

WATER WELL DRILLERS LOG

10-17 1968 B B Nicholas Neshoba
date well completed firm name county well located

LANDOWNER: Joe Hardy
Shila
Miss - Rt 5
(mailing address)


description of formations encountered	from	to
<u>Co. S. of Clay</u>	<u>0'</u>	<u>23'</u>
<u>Blue dirt</u>	<u>23'</u>	<u>40'</u>
<u>Shell</u>	<u>40'</u>	<u>45'</u>
<u>Mix Sand & Clay</u>	<u>45'</u>	<u>60'</u>
<u>Water Sand</u>	<u>60'</u>	<u>77'</u>

WELL LOCATION:
sec. 30 T. 10 N R. 10 E
S W
7 1/2 miles N-E of Adison
(distance) (direction) (nearest town)

WELL PURPOSE: home
(home, irrigation, municipal, industrial)


- WELL COMPLETION DATA:
- (1) diameter (inches) 4 1/4"
 - (2) total depth (feet) 77'
 - (3) static water level (feet) 40' below above top of ground.
 - (4) casing Galv pipe 72'
(material) (depth)
2" if telescope see back.
(size)
 - (5) screen 5 ft 77'
(length) (depth to top)
1 1/2" Steel
(size) (material)
 - (6) pump 1/2 12
(HP) (yield gpm)
Electric
(type power)
 - (7) electric log no
(yes or no)
no
(organization running log)
 - (8) how well bottom plugged Screen

DRILLERS REMARKS:

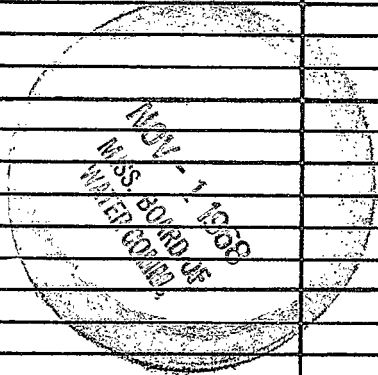

If well telescopes please sketch and show depths.

GROUND LEVEL

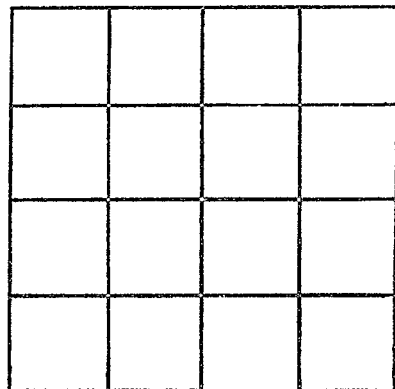

SECTION 30

Please indicate well location X.

ADDITIONAL INFORMATION

If more than one screen, show locations of each on sketch.