

5 13T

324200N 0891430

CODED

TEWS?

MISSISSIPPI  
 BOARD OF WATER COMMISSIONERS  
 416 North State Street  
 Jackson, Mississippi 39201

WATER WELL DRILLERS LOG

Neshoba  
J5  
8-27-68

8-27 1968 F. B. Nicholson Neshoba  
 date well completed firm name county well located

LANDOWNER: Lindley E. Harrison

description of formations encountered

from to

Chilca  
Miss. Rtg  
 (mailing address)

Clay 0' 14'  
20' fine sand & clay 12' 23'  
white sand 23' 31'

WELL LOCATION:


sec. 23 T 10 N R 10 E  
 S W  
9 miles west of Chilca  
 (distance) (direction) (nearest town)

WELL PURPOSE: home  
 (home, irrigation, municipal, industrial)

WELL COMPLETION DATA:

- (1) diameter (inches) 4 1/4"
- (2) total depth (feet) 31'
- (3) static water level (feet) 16' below above top of ground.
- (4) casing cast pipe 26'  
 (material) (depth)  
2" if telescope see back.  
 (size)
- (5) screen 5' 31'  
 (length) (depth to top)  
1 1/4" steel  
 (size) (material)
- (6) pump 1/2 9  
 (HP) (yield gpm)  
electric  
 (type power)
- (7) electric log NO  
 (yes or no)  
NO  
 (organization running log)
- (8) how well bottom plugged Screen

DRILLERS REMARKS:

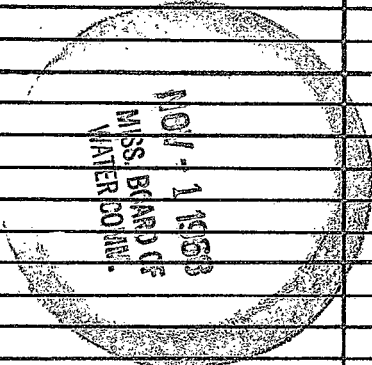

If well telescopes please sketch and show depths.

GROUND LEVEL


SECTION 23

Please indicate well location X.

ADDITIONAL INFORMATION

If more than one screen, show locations of each on sketch.