

CODED

Deshoba
56
6-5-69

MISSISSIPPI
BOARD OF WATER COMMISSIONERS
416 North State Street
Jackson, Mississippi 39201

WATER WELL DRILLERS LOG

6-5 1969 R R Nicholson Deshoba
date well completed firm name county well located

LANDOWNER: William Thomas
Shila
Miss.
(mailing address)

description of formations encountered	from	to
<u>slat</u>	<u>0</u>	<u>28</u>
<u>chalky sand</u>	<u>28</u>	<u>60</u>
<u>shell sand</u>	<u>60</u>	<u>85</u>
<u>W Atl Sand</u>	<u>85</u>	<u>102</u>

WELL LOCATION:
sec. 8 T 10 N R 10 E
S W
12 miles S west of Shila
(distance) (direction) (nearest town)

WELL PURPOSE: home
(home, irrigation, municipal, industrial)


- WELL COMPLETION DATA:
- (1) diameter (inches) 4 1/4
 - (2) total depth (feet) 102
 - (3) static water level (feet) 65 below above top of ground.
 - (4) casing galv. P 98
(material) (depth)
4" if telescope see back.
(size)
 - (5) screen 5' 102
(length) (depth to top)
1 1/4" steel
(size) (material)
 - (6) pump 1 8
(HP) (yield gpm)
elect.
(type power)
 - (7) electric log NO
(yes or no)
- (organization running log)
- (8) how well bottom plugged

DRILLERS REMARKS:

SEP 11 1969
MISS. BD. OF
WATER COM.

If well telescopes please sketch and show depths.

GROUND LEVEL

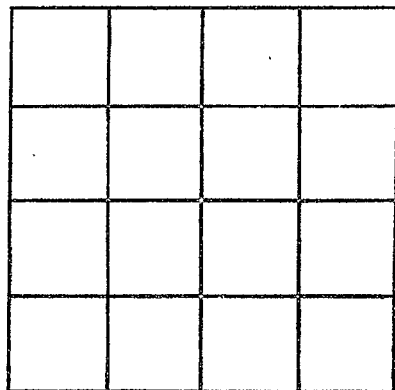

SECTION 8

Please indicate well location X.

ADDITIONAL INFORMATION

If more than one screen, show locations of each on sketch.