

Neshoba
 J8
 9-12-69

MISSISSIPPI
 BOARD OF WATER COMMISSIONERS
 416 North State Street
 Jackson, Mississippi 39201

CODED

CODED

WATER WELL DRILLERS LOG

9-12 1969 B B Neshobian Neshoba
 date well completed firm name county well located

LANDOWNER: Cecil Eastman
 Shiloh, Miss.
 (mailing address)

description of formations encountered	from	to
	Clay	0
Chalky sand	25	50
Shell & rock	50	175
Mix dirt & sand	175	185
Clear sand	185	202

WELL LOCATION:
 sec. 6 T. 10 N R. 10 E
 S
 14 miles W of Shiloh
 (distance) (direction) (nearest town)

WELL PURPOSE: home
 (home, irrigation, municipal, industrial)

- WELL COMPLETION DATA:
- (1) diameter (inches) 4 1/4
 - (2) total depth (feet) 202
 - (3) static water level (feet) 125 below above top of ground.
 - (4) casing galv. P. 192
 (material) (depth)
2" if telescope see back.
 (size)
 - (5) screen 10 ft. 202
 (length) (depth to top)
1 1/4" Steel
 (size) (material)
 - (6) pump 2 10
 (HP) (yield gpm)
Elect.
 (type power)
 - (7) electric log ✓
 (yes or no)

(organization running log)

(8) how well bottom plugged Screen


DRILLERS REMARKS:

JAN 21 1970

MISS. BD. OF
 WATER COMM.

If well telescopes please sketch and show depths.

GROUND LEVEL

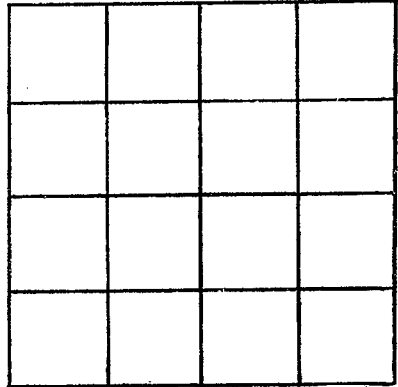

SECTION 6

Please indicate well location X.

ADDITIONAL INFORMATION

If more than one screen, show locations of each on sketch.