

Neshoba
J 9
5-70

MISSISSIPPI
 BOARD OF WATER COMMISSIONERS
 416 North State Street
 Jackson, Mississippi 39201

3 BC WATER WELL DRILLERS LOG

MAW 1970 Thomas & Son Neshoba
 date well completed firm name county well located

LANDOWNER: Mr. B. B. McDonald
Rt. 9
Philadelphia, Miss.
 (mailing address) 147

description of formations encountered	from	to
	<u>SAND</u>	<u>0</u>
<u>BLACK DIRT</u>	<u>21</u>	<u>64</u>
<u>ROCK & SHELL</u>	<u>64</u>	<u>84</u>
<u>SAND</u>	<u>84</u>	<u>86</u>
<u>ROCK</u>	<u>86</u>	<u>90</u>
<u>STREAKS GREEN SAND</u>	<u>90</u>	<u>110</u>
<u>ROCK & SHELL</u>		

WELL LOCATION:
 sec. 20 T. 10 S. R. 10 E.
1 miles N of Dowdville
 (distance) (direction) (nearest town)

WELL PURPOSE:
 (home, irrigation, municipal, industrial)


- WELL COMPLETION DATA:
- diameter (inches) 2
 - total depth (feet) 110
 - static water level (feet) 60 below above top of ground.
 - casing SAV. 82
 (material) (depth)
2 if telescope see back.
 (size)
 - screen open
 (length) (depth to top)
 (size) (material)
 - pump 1/2 ROB 14
 (HP) (yield gpm)
elec
 (type power)
 - electric log NO
 (yes or no)
- (organization running log)
- (8) how well bottom plugged _____

JUN 11 1970

DRILLERS REMARKS:

If well telescopes please sketch and show depths.

GROUND LEVEL

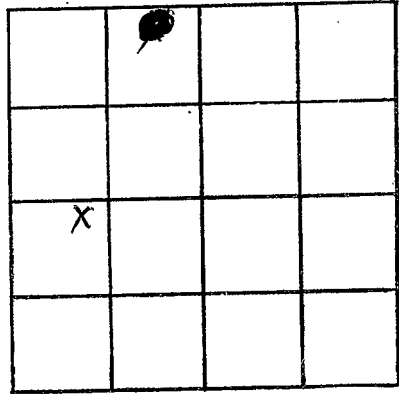

SECTION 020

Please indicate well location X.

ADDITIONAL INFORMATION

If more than one screen, show locations of each on sketch.