

Neshoba
J 10
7-7-70

MISSISSIPPI
 BOARD OF WATER COMMISSIONERS
 416 North State Street
 Jackson, Mississippi 39201

Coded

WATER WELL DRILLERS LOG

7-7 1970 RR Nickerson Neshoba
 date well completed firm name county well located

LANDOWNER: <u>Wallingford Stripling</u> <u>Shila</u> <u>Miss.</u> (mailing address)	description of formations encountered	from	to
		<u>Clay sand</u>	<u>0</u>
	<u>Chalk & dirt</u>	<u>23</u>	<u>68</u>
	<u>Shell</u>	<u>68</u>	<u>74</u>
	<u>water sand</u>	<u>74</u>	<u>85</u>

WELL LOCATION:
 sec 27 T 10 N R 10 E
11 mi miles West Shila
 (distance) (direction) (nearest town)

WELL PURPOSE: Home
 (home, irrigation, municipal, industrial)

- WELL COMPLETION DATA:
- diameter (inches) 4 1/4
 - total depth (feet) 85
 - static water level (feet) 68 below above top of ground.
 - casing Galv. 80
 (material) (depth)
2"
 (size) if telescope see back.
 - screen 5 85
 (length) (depth to top)
1/4" steel
 (size) (material)
 - pump 1 8
 (HP) (yield gpm)
Elect
 (type power)
 - electric log no
 (yes or no)
- (organization running log)
- (8) how well bottom plugged Screen


MAR 24 1970

MISS. BD. OF
 WATER COMMISSIONERS

DRILLERS REMARKS:

If well telescopes please sketch and show depths.

GROUND LEVEL

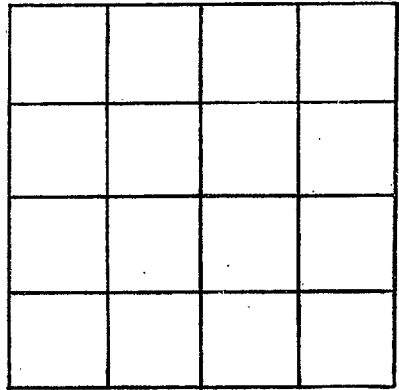

SECTION _____

Please indicate well location X.

ADDITIONAL INFORMATION

If more than one screen, show locations of each on sketch.