

NESHOBA
 J 12
 6-6-70

MISSISSIPPI
 BOARD OF WATER COMMISSIONERS
 416 North State Street
 Jackson, Mississippi 39201

CODED

WATER WELL DRILLERS LOG

6 1 6 1970 F. H. Comens Neshoba
 date well completed firm name county well located

LANDOWNER: Jim Jackson
 (mailing address)

description of formations encountered	from	to
Top Soil	0	30
Coarse Sand	30	35

WELL LOCATION:
 sec 20 T 10 N R 10 E
 S W
 1 1/2 miles S of Sand Hill
 (distance) (direction) (nearest town)

WELL PURPOSE:
 (home, irrigation, municipal, industrial)

- WELL COMPLETION DATA:
- (1) diameter (inches) 2"
 - (2) total depth (feet) 35
 - (3) static water level (feet) 18 below top of ground.
 - (4) casing 2" VAP. 30 (material) (depth)
 2" (size) if telescope see back.
 - (5) screen 1' 5" 35 (length) (depth to top)
 2" (size) Copper (material)
 - (6) pump 1/2 (HP) 240 G (yield gpm)
 C. Inc. (type power)
 - (7) electric log NO (yes or no)
 WSES (organization running log)
 - (8) how well bottom plugged Gold plug

CODED


CEC 1 1970

DRILLERS REMARKS:

MISS. BD. OF
 WATER COMMISSIONERS

If well telescopes please sketch and show depths.

GROUND LEVEL

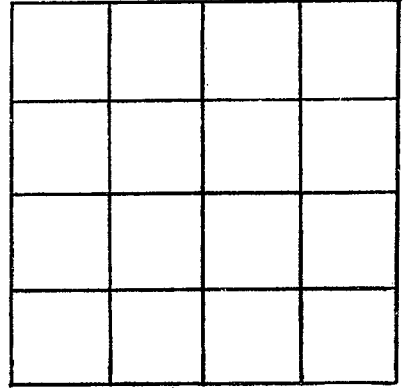

SECTION _____

Please indicate well location X.

ADDITIONAL INFORMATION

If more than one screen, show locations of each on sketch.