

MISSISSIPPI
BOARD OF WATER COMMISSIONERS
416 North State Street
Jackson, Mississippi 39201

CODED

WATER WELL DRILLERS LOG

NESHOBA
J14
1-17-71

1-17 1971 Thomas & Son Neshoba
date well completed firm name county well located

LANDOWNER: T. Parker
Rt-9
Philadelphia, Miss.
(mailing address)

description of fomations encountered	from	to
<u>Red Claychalk</u>	<u>0</u>	<u>20</u>
<u>Black dirt</u>	<u>18</u>	<u>108</u>
<u>Rock & shell</u>	<u>108</u>	<u>120</u>
<u>white coarse sand</u>	<u>120</u>	<u>136</u>

WELL LOCATION:
sec. 22 T. 10 N. R. 10 E.
2 miles 5 W of Fair Ground
(distance) (direction) (nearest town)

WELL PURPOSE:
(home, irrigation, municipal, industrial)

- WELL COMPLETION DATA:
- (1) diameter (inches) 2
 - (2) total depth (feet) 136
 - (3) static water level (feet) 90 ^{below} above top of ground.
 - (4) casing Galv. ~~131~~ 131
(material) (depth)
2"
(size) if telescope see back.
 - (5) screen 5 136
(length) (depth to top)
1 1/4 galv. 5.5
(size) (material)
 - (6) pump 1 5
(HP) (yield gpm)
elec.
(type power)
 - (7) electric log No
(yes or no)
 - (organization running log)
 - (8) how well bottom plugged point

CODED


FEB 23 1971

DRILLERS REMARKS:

MISS. ED. OF
WATER COMM.

If well telescopes please sketch and show depths.

GROUND LEVEL

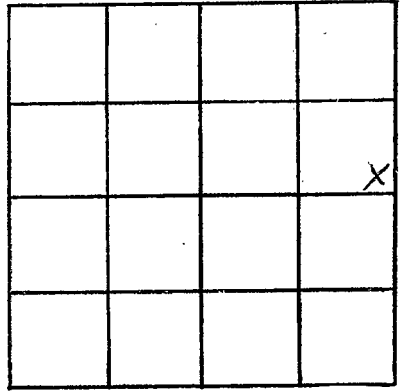

SECTION 22

Please indicate well location X.

ADDITIONAL INFORMATION

If more than one screen,
show locations of each on sketch.