

WESHOPA
815
5-7-71

MISSISSIPPI
 BOARD OF WATER COMMISSIONERS
 416 North State Street
 Jackson, Mississippi 39201

CODED

WATER WELL DRILLERS LOG

5-7 19 71 F.D. COMANS Neshoba
 date well completed firm name county well located

LANDOWNER:	description of formations encountered	from	to
<u>W. D. Clin</u>	20 <u>Red Clay</u>	<u>0</u>	<u>21</u>
<u>RFT 7 Box 156 Philadelphia</u> (mailing address)	<u>Coarse sand</u>	<u>21</u>	<u>42</u>

WELL LOCATION:
 sec. 6 T. 10N R. 10E
5 miles N of MADDER
 (distance) (direction) (nearest town)

WELL PURPOSE:
 (home) irrigation, municipal, industrial

WELL COMPLETION DATA:

(1) diameter (inches) 2"

(2) total depth (feet) 42'

(3) static water level (feet) 6' below above top of ground.

(4) casing G.P. 42'
 (material) (depth)

(size) If telescope see back.

(5) screen 12 42'
 (length) (depth to top)

1/4 55
 (size) (material)

(6) pump 3 115'
 (HP) (yield gpm)

Elec.
 (type power)

(7) electric log NO
 (yes or no)

WALS
 (organization running log)

(8) how well bottom plugged paint

CODED


DRILLERS REMARKS: Please send me some more Bored Holes. Thank you.

MAY 11 1971

MISS. BD. OF WATER COMM.

If well telescopes please sketch and show depths.

GROUND LEVEL

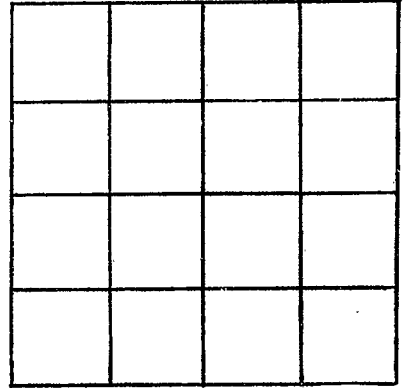

SECTION _____

Please indicate well location X.

ADDITIONAL INFORMATION

If more than one screen, show locations of each on sketch.