

Nes Hobbs
 J16
 11-13-71

MISSISSIPPI
 BOARD OF WATER COMMISSIONERS
 416 North State Street
 Jackson, Mississippi 39201

CODED

WATER WELL DRILLERS LOG

11-13 date well completed
 RR Nicholas, Nes Hobbs firm name county well located

LANDOWNER: Jim Slaughter
 Phila.
 Miss.
 (mailing address)

description of formations encountered	from	to
Clay	0	18
Chalk & dirt	18	40
Mix. Sand & dirt	40	50
Water Sand	50	63

WELL LOCATION:
 sec. 34 T10 N R10 E
 S W
 4 miles west of Dixon
 (distance) (direction) (nearest town)

WELL PURPOSE:
 (home, irrigation, municipal, industrial)

- WELL COMPLETION DATA:
- (1) diameter (inches) 4 1/4"
 - (2) total depth (feet) 63'
 - (3) static water level (feet) 50' below top of ground.
 - (4) casing Galv. 58'
 (material) (depth)
2 1/2" If telescope see back.
 (size)
 - (5) screen 5' 63'
 (length) (depth to top)
1 1/2" Steel
 (size) (material)
 - (6) pump 1/2 7
 (HP) (yield gpm)
Elect
 (type power)
 - (7) electric log
 (yes or no)

 (organization running log)
 - (8) how well bottom plugged

CODED


NOV 15 1971
 NOV 15 1971

MISS. BD. OF
 WATER CONTROL

DRILLERS REMARKS:

If well telescopes please sketch and show depths.

GROUND LEVEL

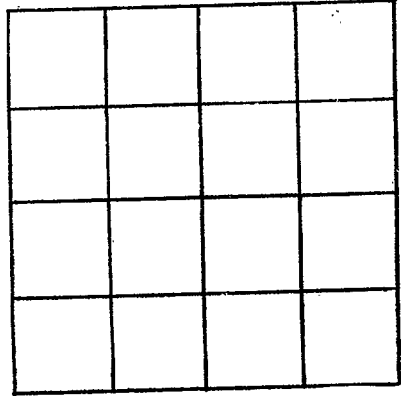

SECTION _____

Please indicate well location X.

ADDITIONAL INFORMATION

If more than one screen, show locations of each on sketch.