

Neshoba  
 J 17  
 11-5-71

MISSISSIPPI  
 BOARD OF WATER COMMISSIONERS  
 416 North State Street  
 Jackson, Mississippi 39201

**CODED**

WATER WELL DRILLERS LOG

11-5-71 date well completed  
 RR Nicholson firm name  
 Neshoba county well located

LANDOWNER: Jessie Kelley  
Phila.  
Miss.  
 (mailing address)

description of formations encountered	from	to
Clay	0	10
Clay Chalk	10	20
Marl Sand & Chalk	20	27
Water Sand	27	37

WELL LOCATION:  
 sec. 24 T. 10 N. R. 10 E.  
8 miles West of Phila.  
 (distance) (direction) (nearest town)

WELL PURPOSE: home  
 (home, irrigation, municipal, industrial)

WELL COMPLETION DATA:  
 (1) diameter (inches) 4 1/4"  
 (2) total depth (feet) 37'  
 (3) static water level (feet) 25' below top of ground.  
 (4) casing Galv. 37'  
 (material) (depth)  
2" if telescope see back.  
 (size)  
 (5) screen 5' 37'  
 (length) (depth to top)  
1 1/4" steel  
 (size) (material)  
 (6) pump 1/2 8  
 (HP) (yield gpm)  
Electr.  
 (type power)  
 (7) electric log             
 (yes or no)  
            
 (organization running log)

**CODED**


NOV 15 1972

MISS. BD. OF  
 WATER COMMISSIONERS

(8) how well bottom plugged             
 DRILLERS REMARKS:

If well telescopes please sketch and show depths.

GROUND LEVEL

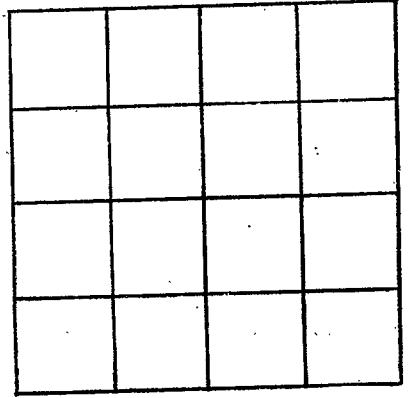

SECTION \_\_\_\_\_

Please indicate well location X.

ADDITIONAL INFORMATION

If more than one screen, show locations of each on sketch.