

NESHOBA

~~ALBANY~~
8-18
11-27-71

MISSISSIPPI
BOARD OF WATER COMMISSIONERS
416 North State Street
Jackson, Mississippi 39201

WATER WELL DRILLERS LOG

CONFIDENTIAL

11-27 date well completed
1971 BR Nicholson firm name
Neshoba county well located

LANDOWNER: Bill Strickland
Union
Miss -
(mailing address)

description of formations encountered	from to	
	feet	feet
Chalk & clay	0	20
mix sand & dirt	20	50
blue dirt	50	100
rock	100	107
blue dirt	107	170
water sand	170	200

WELL LOCATION:
sec. 13 T10 N R10 E
S W
11 miles west of Union
(distance) (direction) (nearest town)

WELL PURPOSE: home
(home, irrigation, municipal, industrial)

- WELL COMPLETION DATA:
- (1) diameter (inches) 4 1/4"
 - (2) total depth (feet) 200'
 - (3) static water level (feet) 48' below above top of ground.
 - (4) casing Galv. 100' (material) (depth)
If telescope see back. (size)
 - (5) screen (length) (depth to top)
(size) (material)
 - (6) pump 1/2 (HP) 17 (yield gpm)
elect- (type power)
 - (7) electric log (yes or no)
(organization running log)
 - (8) how well bottom plugged

CONFIDENTIAL


MAY 15 1972

MISS. DEP. OF
WATER COM.

DRILLERS REMARKS:

If well telescopes please sketch and show depths.

GROUND LEVEL

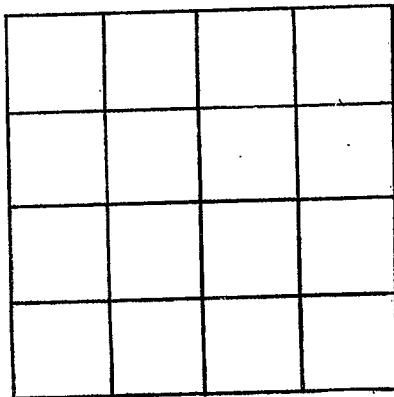

SECTION _____

Please indicate well location X.

ADDITIONAL INFORMATION

If more than one screen, show locations of each on sketch.