

NESHOBA

J20

8-15-74

MISSISSIPPI BOARD OF WATER COMMISSIONERS  
416 North State Street  
Jackson, Mississippi 39201

CODED

WATER WELL DRILLERS LOG

8-15-74 19  
date well completed

F.D. Combs  
firm name

NESHOBA  
county well located

LANDOWNER:

Jimmie Sauls  
Philadelphia, Miss. R. 7.  
(mailing address)

description of formations encountered

from to

Red Clay	0	22
Loam	22	31
Hard Sand	31	55
Calc. Sand	55	74

WELL LOCATION:

sec. 9 T 100 N R 10 E  
1 miles N of (distance) (direction) (nearest town)

WELL PURPOSE:

(home) irrigation, municipal, industrial

WELL COMPLETION DATA:

- (1) diameter (inches) 2"
- (2) total depth (feet) 84'
- (3) static water level (feet) 40' below top of ground.
- (4) casing 2" P.C. 79' (material) (depth)  
2" (size) If telescope see back.
- (5) screen 2" F.G. 84' (length) (depth to top)  
2" F.G. R. (size) (material)
- (6) pump 1 (HP) 120 (yield gpm)  
Euler (type power)
- (7) electric log 110 (yes or no)

CODED

(organization running log)

(8) how well bottom plugged Cap

DISCLOSURE

AUG 19 1974


DRILLERS REMARKS:

Please send me some more self address envelopes -  
Thank you -

MISS. BD. OF WATER COMM

If well telescopes please sketch and show depths.

GROUND LEVEL

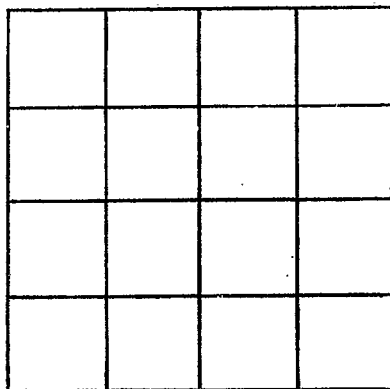

SECTION \_\_\_\_\_

Please indicate well location X.

ADDITIONAL INFORMATION

If more than one screen, show locations of each on sketch.