

MISSISSIPPI  
BOARD OF WATER COMMISSIONERS  
416 North State Street  
Jackson, Mississippi 39201

CODED

WATER WELL DRILLERS LOG

J 23  
Neshoba  
6/2/75

6-2-75 19  
date well completed

F. D. Conroy  
firm name

NESHOBA  
county well located

LANDOWNER: Ray Wentson  
R.R. 7  
Philadelphia, Miss.  
(mailing address)


description of formations encountered	from	to
Red clay	0	42
Shells	42	53
Coars. Sand	53	84

WELL LOCATION:  
sec. 6 T10N R10E  
1/4 miles N of Zouret Hill  
(distance) (direction) (nearest town)

WELL PURPOSE: Chicken house  
(Irrigation, municipal, industrial)

CODED

- WELL COMPLETION DATA:
- (1) diameter (inches) 9"
  - (2) total depth (feet) 84'
  - (3) static water level (feet) 30' below top of ground.
  - (4) casing 9" PVC 78'  
(material) (depth)  
9" If telescope see back.  
(size)
  - (5) screen 9" FG 84'  
(length) (depth to top)  
9" F.C.P.  
(size) (material)
  - (6) pump 1 (HP) 220 (yield gpm)  
Elec. (type power)
  - (7) electric log 40 (yes or no)
- (organization running log)

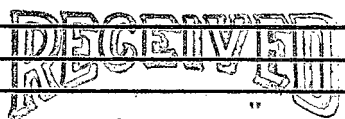

JUN 5 1975

(8) how well bottom plugged Cap

DRILLERS REMARKS:

MISS. BD. OF WATER COMM.

If well telescopes please sketch and show depths.

GROUND LEVEL


SECTION \_\_\_\_\_

Please indicate well location X.

ADDITIONAL INFORMATION

If more than one screen, show locations of each on sketch.