

Neshoba
J 200
7/76

MISSISSIPPI
BOARD OF WATER COMMISSIONERS
416 North State Street
Jackson, Mississippi 39201

13T

WATER WELL DRILLERS LOG

July 1976 date well completed
Thomas & Son firm name
Neshoba county well located

LANDOWNER: Charles Strubling
Phila. Miss.
(mailing address)

description of formations encountered	from	to
Red Clay	0	5
Pipe "	5	10
Black Dirt	10	48
Rock & Shell	48	63
Green Sand	63	100
Rock-Black Dirt & STKs SAND	100	130
Mostly coarse SAND w/ STK BLK Dirt.	130	145

WELL LOCATION:
sec. 8 T. 10 N. S. R. 10 E. W. Phila.
10 miles SW of (distance) (direction) (nearest town)

WELL PURPOSE:
(home, irrigation, municipal, industrial)

- WELL COMPLETION DATA:
- (1) diameter (inches) 2" PVC
 - (2) total depth (feet) 145
 - (3) static water level (feet) 60 below top of ground
 - (4) casing (material) PVC (depth) 135 (size) 2 If telescope see back.
 - (5) screen (length) 10 (depth to top) 135 (size) 2" 8 slot PVC (material)
 - (6) pump (HP) 1 (yield gpm) 6 (type power) elec
 - (7) electric log NO (yes or no)
 - (organization running log)
 - (8) how well bottom plugged Partial


RECEIVED
AUG 16 1976

MISS. BD. OF WATER COMMISSIONERS

DRILLERS REMARKS:

If well telescopes please sketch and show depths.

GROUND LEVEL

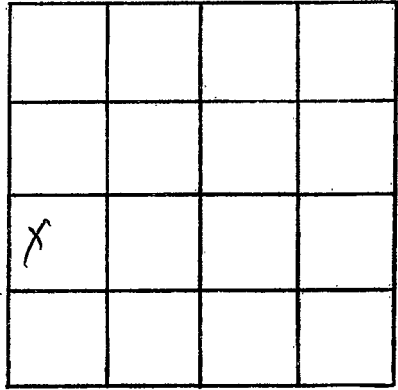

SECTION 8

Please indicate well location X.

ADDITIONAL INFORMATION

If more than one screen, show locations of each on sketch.