

Neshoba  
 J 2001  
 Sept 1976

MISSISSIPPI  
 BOARD OF WATER COMMISSIONERS  
 416 North State Street  
 Jackson, Mississippi 39201

WATER WELL DRILLERS LOG

Sept. 19 76 date well completed  
 Thomas & Son firm name  
 Neshoba county well located

LANDOWNER: Mrs. E. Williamson  
 Rt-9  
 Philadelphia, Miss.  
 (mailing address)

Description of formations encountered	from	to
SAND	0	5
RED CLAY	5	12
ALL SAND	12	45

WELL LOCATION:  
 sec. 30 T 10 N R 10 E  
 11 miles SW of Phila.  
 (distance) (direction) (nearest town)

WELL PURPOSE:  
 (home, irrigation, municipal, industrial)

- WELL COMPLETION DATA:
- (1) diameter (inches) 2
  - (2) total depth (feet) 45
  - (3) static water level (feet) 28 (below above top of ground)
  - (4) casing (material) PVC (depth) 40  
 2 (size) If telescope see back.
  - (5) screen (length) 5 (depth to top) 40  
 2 (size) 8310 PVC (material)
  - (6) pump 1/2 (HP) 5 (yield gpm)  
 Elec. (type power)
  - (7) electric log NO (yes or no)
- (organization running log)
- (8) how well bottom plugged part


DRILLERS REMARKS:

RECEIVED

DEC 23 1976

If well telescopes please sketch and show depths.

GROUND LEVEL

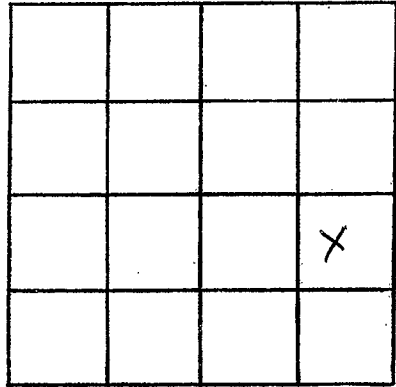

SECTION 30

Please indicate well location X.

ADDITIONAL INFORMATION

If more than one screen, show locations of each on sketch.