

NESHORA  
 J 2002  
 2/77

MISSISSIPPI  
 BOARD OF WATER COMMISSIONERS  
 416 North State Street  
 Jackson, Mississippi 39201

13T

WATER WELL DRILLERS LOG

March 19 27 date well completed  
 The Mast & Son firm name  
 Neshoba county well located

LANDOWNER: Gary Chamberlee  
 Philadelphia, Miss.  
 (mailing address)

WELL LOCATION:  
 sec. 8 T 10 N R. 10 E  
 S W  
 9 miles S W of Phila.  
 (distance) (direction) (nearest town)

WELL PURPOSE: Chicken House  
 (home, irrigation, municipal, industrial)

WELL COMPLETION DATA:

(1) diameter (inches) 2  
 (2) total depth (feet) 205  
 (3) static water level (feet) 84 below top of ground.  
 (4) casing (material) (depth) 180  
 2 (size) If telescope see back.  
 (5) screen (length) (depth to top) open  
 (size) (material)  
 (6) pump (HP) (yield gpm) 1 6  
 (type power) Elec.  
 (7) electric log No (yes or no)  
 (organization running log)  
 (8) how well bottom plugged open

description of formations encountered	from	to
Red CLAY	0	10
SAND ROCK	10	18
Dirty Mealy Sand & CHALK	18	86
Blue Chalk & some Rock	86	130
SAND	130	134
HARD STATE ROCK	134	185
SAND	185	187
Rock	187	189
Coarse Sand w/ STKS HARD CHALK	189	205


DRILLERS REMARKS:

RECEIVED  
 APR 1 1977

MISS. BD. OF WATER COM.

If well telescopes please sketch and show depths.

GROUND LEVEL

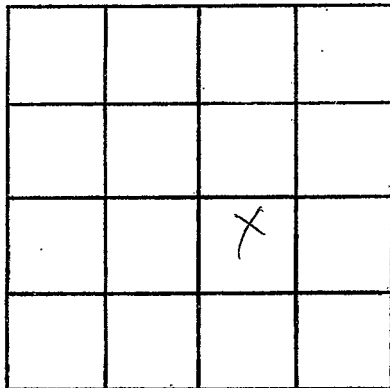

SECTION 8

Please indicate well location X.

ADDITIONAL INFORMATION

If more than one screen, show locations of each on sketch.