

NESHOBA  
 J. 2003  
 10/21/77

MISSISSIPPI  
 BOARD OF WATER COMMISSIONERS  
 416 North State Street  
 Jackson, Mississippi 39201

13T

WATER WELL DRILLERS LOG

10-21-77 19 J.D. Powers NESHOBA  
 date well completed firm name county well located

LANDOWNER	Description of formations encountered	from	to
<u>Curtis Deaton</u>	<u>Red Clay</u>	<u>18</u>	
<u>RT. 5 PMICA</u>	<u>Sand</u>	<u>23</u>	
(mailing address)	<u>Rock</u>	<u>50</u>	
WELL LOCATION:	<u>Black sand</u>	<u>84</u>	
sec <u>16 @ 10 @ 10 @ Hill</u>	<u>Green sand mud</u>	<u>100</u>	
<u>3</u> miles <u>S</u> of <u>LAURE</u>	<u>Green sand</u>	<u>129</u>	
(distance) (direction) (nearest town)	<u>Rock</u>	<u>240</u>	
WELL PURPOSE:	<u>Green sand</u>	<u>263</u>	
(home, irrigation, municipal, industrial)			
WELL COMPLETION DATA:			
(1) diameter (inches) <u>2"</u>			
(2) total depth (feet) <u>263</u>			
(3) static water level (feet) <u>110</u> below above top of ground.			
(4) casing <u>2" PVC 154'</u>			
(material) (depth)			
<u>2"</u> if telescope see back.			
(size)			
(5) screen <u>2x6 Shell tarp</u>			
(length) (depth to top)			
(size) (material)			
(6) pump _____ (HP) _____ (yield gpm)			
(type power)			
(7) electric log <u>NO</u> (yes or no)			
(organization running log)			
(8) how well bottom plugged <u>open</u>			
DRILLERS REMARKS:			
<u>Sam Chadler</u>			
Request Photostatic Copy of this well log			


RECEIVED

OCT 26 1977

MISS. BD. OF WATER COMMISSIONERS

If well telescopes please sketch and show depths.

GROUND LEVEL

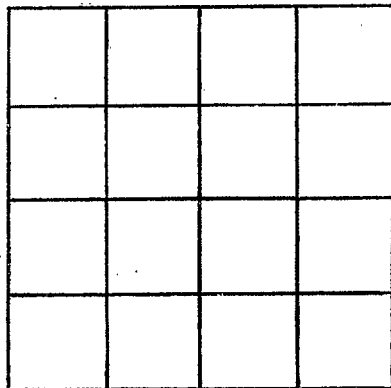

SECTION \_\_\_\_\_

Please indicate well location X.

ADDITIONAL INFORMATION

If more than one screen, show locations of each on sketch.