

NESHABA
 J 2005
 3/78

MISSISSIPPI
 BOARD OF WATER COMMISSIONERS
 416 North State Street
 Jackson, Mississippi 39201

WATER WELL DRILLERS LOG

March 1978 Thomas Kew Neshoba
 date well completed firm name county well located

LANDOWNER: Cullen Thomas
 Rt-9
 Phila., Miss.
 (mailing address)

description of formations encountered	from	to
Red CLAY	0	4
All SAND	4	40

WELL LOCATION:
 sec. 33 T 10 N R 10 E
 10 miles SW of Phila.
 (distance) (direction) (nearest town)

WELL PURPOSE:
 (home, irrigation, municipal, industrial)

- WELL COMPLETION DATA:
- (1) diameter (inches) 2
 - (2) total depth (feet) 40
 - (3) static water level (feet) 25 below top of ground.
 - (4) casing PVC 35' (material) (depth)
 2 (size) if telescope see back.
 - (5) screen 5' 35' (length) (depth to top)
 2" PVC 8 slot (size) (material)
 - (6) pump 1/2 HP 7 (yield gpm)
 E. Kew (type power)
 - (7) electric log NO (yes or no)
 (organization running log)
 - (8) how well bottom plugged Paint


RECEIVED
 APR - 3 1978

DRILLERS REMARKS:

MISS. BD. OF WATER COMM.

If well telescopes please sketch and show depths.

GROUND LEVEL

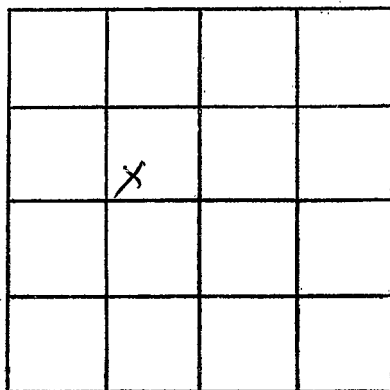

SECTION 73

Please indicate well location X.

ADDITIONAL INFORMATION

If more than one screen,
show locations of each on sketch.