

Neshoba
 J 2008
 8-29-80

MISSISSIPPI
 BOARD OF WATER COMMISSIONERS
 416 North State Street
 Jackson, Mississippi 39201

WATER WELL DRILLERS LOG

8-29 1980 Beech Smith Neshoba
 date well completed firm name county well located

LANDOWNER:	description of formations encountered	from	to
Harry Banks	red clay	0	35
Phila Miss (mailing address)	black chalk	35	85
	blue sand	85	105
WELL LOCATION:			
sec. 1 T. 10 N. R. 20 E. S W 5 miles south W of Phila (distance) (direction) (nearest town)			
WELL PURPOSE: home (home, irrigation, municipal, industrial)			
WELL COMPLETION DATA:			
(1) diameter (inches) 2"			
(2) total depth (feet) 105'			
(3) static water level (feet) 59 below above top of ground.			
(4) casing PVC, 100' (material) (depth)			
(size) if telescope see back.			
(5) screen 5' 100' (length) (depth to top)			
008' PVC (size) (material)			
(6) pump 1/2 HP 100 (HP) (yield gpm)			
ele. (type power)			
(7) electric log (yes or no)			
(organization running log)			
(8) how well bottom plugged back Wash valve			
DRILLERS REMARKS:			


DEPT. OF NATURAL RESOURCES
 BUREAU OF LAND & WATER RESOURCES

SEP 30 1980

RECEIVED

If well telescopes please
sketch and show depths.

GROUND LEVEL

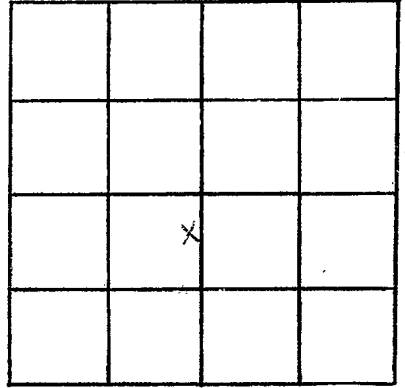

SECTION 1

Please indicate well location X.

ADDITIONAL INFORMATION

If more than one screen,
show locations of each on sketch.