

Neshoba
J 200

MISSISSIPPI
BOARD OF WATER COMMISSIONERS
416 North State Street
Jackson, Mississippi 39201

5/181

WATER WELL DRILLERS LOG

date well completed 19 81 firm name Thomas county well located Neshoba


LANDOWNER: Grady Pullen
Rt. 9
Phila. MS.
(mailing address)

description of formations encountered	from	to
Red SAND	0	30
Black D.V.T	30	92
Rock & shell	92	105
Green SAND	105	118
All Shell	118	127
Green SAND	127	141
Grey SAND	141	150
Coarse white SAND	150	175

WELL LOCATION:
sec 36 T 10 N R 10 E
S W
7 miles SW of Phila
(distance) (direction) (nearest town)

WELL PURPOSE: Chicken House
(home, irrigation, municipal, industrial)


- WELL COMPLETION DATA:
- (1) diameter (inches) 4
 - (2) total depth (feet) 175
 - (3) static water level (feet) 90 ⁶⁶low above top of ground
 - (4) casing PVC 155 (material) (depth)
2 (size) if telescope see back.
 - (5) screen 20 155 (length) (depth to top)
2 PVC 10 slot (size) (material)
 - (6) pump 3/4 18 (HP) (yield gpm)
 - Elec: (type power)
 - (7) electric log NO (yes or no)
 - (organization running log)
 - (8) how well bottom plugged Part

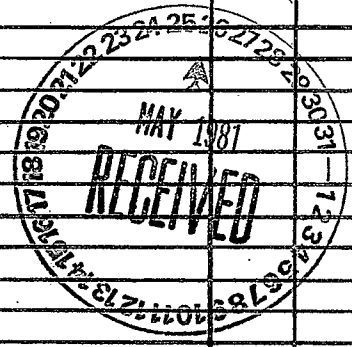

DRILLERS REMARKS:

If well telescopes please sketch and show depths.

GROUND LEVEL

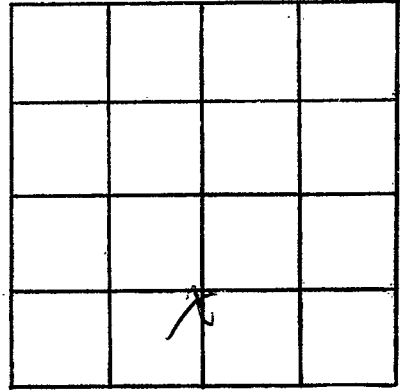

SECTION 36

Please indicate well location X.

ADDITIONAL INFORMATION

If more than one screen, show locations of each on sketch.