

NESHOTA
 J 2011
 11/81

MISSISSIPPI
 BOARD OF WATER COMMISSIONERS
 416 North State Street
 Jackson, Mississippi 39201

WATER WELL DRILLERS LOG

Nov 1981 date well completed
 Thomas firm name
 Neshota county well located

LANDOWNER: Downy Pentberg
 Rt-5
 Phila, MS
 (mailing address)

description of formations encountered	from	to
Red Clay	0	6
Red Clay	6	20
Lots of Sand Reol.	20	80
& Dirty yellow Sand		
SAND	80	119
Slate Perm. Rd.		
CHALK ON TO	200	FT.

WELL LOCATION:
 sec. 6 T-12N S R-10E
 10 miles S W of Phila.
 (distance) (direction) (nearest town)

WELL PURPOSE: Chicken House
 (home, irrigation, municipal, industrial)

- WELL COMPLETION DATA:
- diameter (inches) 4
 - total depth (feet) 120
 - static water level (feet) 54 ^{below} above top of ground.
 - casing (material) PVC (depth) 100
 4" (size) if telescope see back.
 - screen (length) 20 (depth to top) 100
 4" (size) 10 slot PVC (material)
 - pump (HP) 3/4 (yield gpm) 18
 2 hp (type power)
 - electric log NO (yes or no)
- (organization running log)
- (8) how well bottom plugged fair

DEPT. OF NATURAL RESOURCES
 BUREAU OF LAND & WATER RESOURCES


DEC 28 1981

RECEIVED

DRILLERS REMARKS:

If well telescopes please
sketch and show depths.

GROUND LEVEL

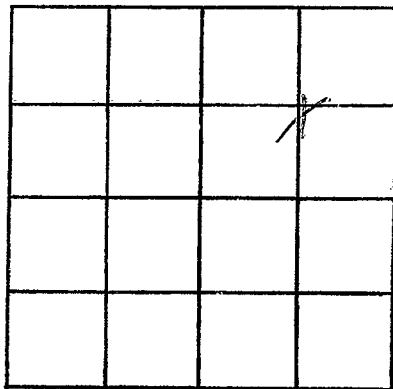

SECTION 6

Please indicate well location X.

ADDITIONAL INFORMATION

If more than one screen,
show locations of each on sketch.