

Neshoba
 J 2012
 5-29-81

MISSISSIPPI
 BOARD OF WATER COMMISSIONERS
 416 North State Street
 Jackson, Mississippi 39201

WATER WELL DRILLERS LOG

5-29-81 date well completed THOMAS firm name Neshoba county well located

LANDOWNER: Sidney Pullen
 DIXON R 9.
 Philadelphia, MS
 (mailing address)


description of formations encountered	from	to
Red Clay	0	10
SAND	10	26
BLACK DIRT	26	40
Red SAND CHALK	40	46
HARD BLACK DIRT	46	99
Rock + shell	99	114
G SAND	114	123
Rock + shell	123	135
Green SAND	135	143

WELL LOCATION:
 sec 36 T 10 N R 10 E
 7 miles S W of Phila.
 (distance) (direction) (nearest town)

WELL PURPOSE:
 (home, irrigation, municipal, industrial)


WELL COMPLETION DATA:
 (1) diameter (inches) 2
 (2) total depth (feet) 143
 (3) static water level (feet) 9 below top of ground.
 (4) casing PVC 110 (material) (depth)
 2 (size) if telescope see back.
 (5) screen open (length) (depth to top)
 (size) (material)
 (6) pump 1 (HP) 5 (yield gpm)
 Elec (type power)
 (7) electric log NO (yes or no)
 (organization running log)
 (8) how well bottom plugged POINT

DRILLERS REMARKS: 1 Hp Gould
 101 ft to jet

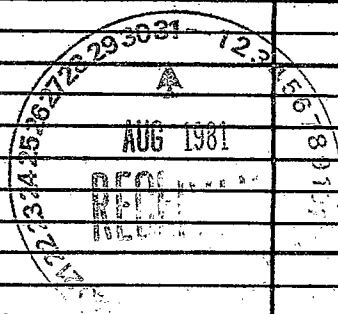

If well telescopes please sketch and show depths.

GROUND LEVEL

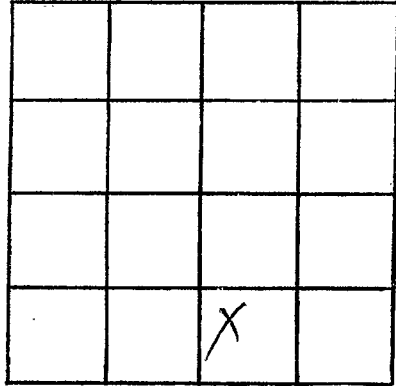

SECTION 36

Please indicate well location X.

ADDITIONAL INFORMATION

A series of horizontal lines for writing additional information.

If more than one screen, show locations of each on sketch.