

NESTOBA
J 2013

MISSISSIPPI DEPARTMENT OF NATURAL RESOURCES
Bureau of Land and Water Resources
Southport Mall
P.O. Box 10631
Jackson, Mississippi 39209
WATER WELL DRILLERS LOG

12-18-1985 date well completed
F. O. Conway firm name
NESTOBA county well located

LANDOWNER: Theremosa Sikes
Downside
(mailing address)

description of formations encountered	from	to
red clay	0	40
sand	40	50
black dirt	50	90
rock	90	110
sand and coal	110	148

WELL LOCATION:
sec. 30 T10N R10E
S W
12 miles W of PHILADELPHIA
(distance) (direction) (nearest town)

WELL PURPOSE:
 (home) irrigation, municipal, industrial

- WELL COMPLETION DATA:
- (1) diameter (inches) 2"
 - (2) total depth (feet) 148'
 - (3) static water level (feet) 80 below top of ground.
 - (4) casing 2" 148'
(material) (depth)
2"
(size) if telescope see back.
 - (5) screen 2" 148'
(length) (depth to top)
2x6 Shell wrap
(size) (material)
 - (6) pump 1 110
(HP) (yield gpm)
Elec.
(type power)
 - (7) electric log no
(yes or no)
open
(organization running log)
 - (8) how well bottom plugged _____

RECEIVED


DEC 20 1985

DRILLERS REMARKS:

Department of Natural Resources
Bureau of Land & Water Resources

If well telescopes please sketch and show depths.

GROUND LEVEL

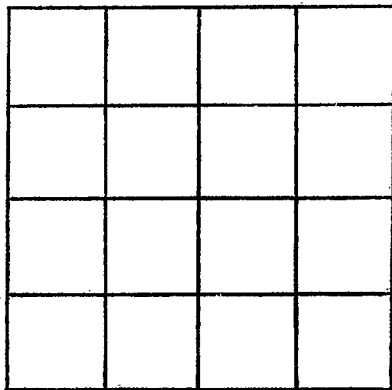

SECTION _____

Please indicate well location X.

ADDITIONAL INFORMATION

If more than one screen,
show locations of each on sketch.