

MISSISSIPPI DEPARTMENT OF NATURAL RESOURCES

Bureau of Land and Water Resources

Southport Mall

P.O. Box 10631

Jackson, Mississippi 39209

WATER WELL DRILLERS LOG

Neshoba
J
2014

May 19 1986
 date well completed

THOMAS DRILLING & SUPPLY CO.
 firm name

Neshoba
 county well located

LANDOWNER: Tim Spears
Rt. 9 Box 146
Philadelphia, MS
 (mailing address)

description of formations encountered	from	to
Brown Dirt	0	10
Red sand	10	20
Rock	20	21
Yellow sand	21	40
Rock & chalk	40	42
White sand	42	60

WELL LOCATION:
 sec. 13 T. 10 (N) R. 10 (E)
 S W
1 miles S of Kound Hill
 (distance) (direction) (nearest town)

WELL PURPOSE: Home
 (home, irrigation, municipal, industrial)

- WELL COMPLETION DATA:
- (1) diameter (inches) 2"
 - (2) total depth (feet) 60'
 - (3) static water level (feet) 40' below top of ground.
 - (4) casing PVC, 60' (material) (depth)
2" if telescope see back. (size)
 - (5) screen 10', 50' (length) (depth to top)
2" (size) PVC (material)
 - (6) pump 1 (HP) 5 (yield gpm)
Elec. (type power)
 - (7) electric log — (yes or no)
— (organization running log)
 - (8) how well bottom plugged cap


RECEIVED
 JUN 17 1986

Department of Natural Resources
 Bureau of Land & Water

DRILLERS REMARKS:

If well telescopes please sketch and show depths.

GROUND LEVEL

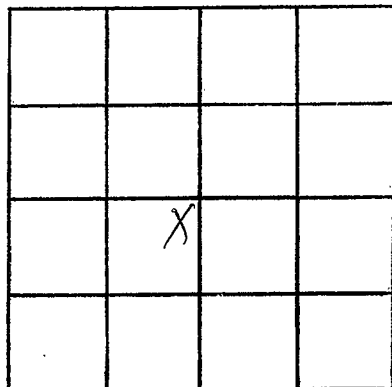

SECTION 14

Please indicate well location X.

ADDITIONAL INFORMATION

If more than one screen, show locations of each on sketch.