

NEH03A  
 J 2015

MISSISSIPPI DEPARTMENT OF NATURAL RESOURCES  
 Bureau of Land and Water Resources  
 Southport Mall  
 P.O. Box 10631  
 Jackson, Mississippi 39209  
**WATER WELL DRILLERS LOG**

3-28-1977 F. D. Connors NEH03A  
 date well completed firm name county well located

LANDOWNER: J. A. Jones  
 (mailing address)


description of formations encountered	from	to
<u>Coak</u>	<u>0</u>	<u>20</u>
<u>red clay</u>	<u>20</u>	<u>60</u>
<u>50' of</u>	<u>60</u>	<u>70</u>
<u>calc white sand</u>	<u>70</u>	<u>105</u>

WELL LOCATION:  
 sec. 6 T 2 N R 10 E  
10 miles N of Courtney  
 (distance) (direction) (nearest town)

WELL PURPOSE:  
 (home) irrigation, municipal, industrial

- WELL COMPLETION DATA:
- (1) diameter (inches) 2"
  - (2) total depth (feet) 105'
  - (3) static water level (feet) 80' below top of ground.
  - (4) casing 2" (material), 105' (depth)  
2" (size) if telescope see back.
  - (5) screen 2" (length), 105' (depth to top)  
2x10 (size), PVC (material)
  - (6) pump 1 (HP), 220 (yield gpm)  
Elec. (type power), 9pm
  - (7) electric log 110 (year or no.)  
Sand Shoop (organization running log)
  - (8) how well bottom plugged \_\_\_\_\_

DRILLERS REMARKS:

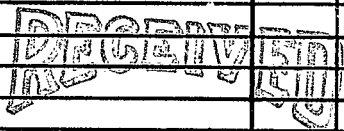


MAR 31 1977

Department of Natural Resources  
 Bureau of Land & Water Resources

If well telescopes please sketch and show depths.

GROUND LEVEL

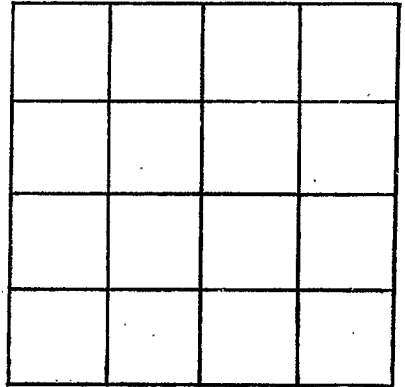

SECTION \_\_\_\_\_

Please indicate well location X.

ADDITIONAL INFORMATION

If more than one screen, show locations of each on sketch.