

**MISSISSIPPI DEPARTMENT OF ENVIRONMENTAL QUALITY**

Office of Land and Water Resources

P. O. Box 10631  
Jackson, MS 39289-0631  
**WATER WELL DRILLERS LOG**

COUNTY WELL LOCATED <i>Neshoba</i>	
WELL NUMBER <i>9-2022</i>	CODED
DATE WELL COMPLETED <i>9-21-02</i>	

PERMIT NUMBER
NAME OF DRILLING FIRM <i>Thomas Drilling</i>
<i>Carthage, MS</i>

NAME & MAILING ADDRESS OF LANDOWNER <i>Jill Hollis</i>			
<i>2200 Mams Hill Rd</i>			
Latitude:	Longitude: <i>CANTMAGE MS 39051</i>		
WELL LOCATION.	SEC <i>7</i>	TOWNSHIP <i>10<sup>00</sup>S</i>	RANGE <i>10<sup>00</sup>W</i>
DISTANCE <i>1/4</i> Miles	DIRECTION <i>N</i>	NEAREST TOWN <i>of Laurel Hill</i>	
OTHER LANDMARK <i>1/2 mile E. of County line</i>			
WELL PURPOSE: <i>Home</i> , Irrigation, Municipal, Industrial, Fish Pond, etc.			

PUMP DATA		
PUMP TYPE (Circle One): <input checked="" type="radio"/> Submersible, <input type="radio"/> Turbine, <input type="radio"/> Jet, <input type="radio"/> Flowing Well, Other (Describe) _____		
POWER TYPE (Circle One): <input checked="" type="radio"/> Electric, <input type="radio"/> Tractor, <input type="radio"/> Diesel, <input type="radio"/> Gasoline, <input type="radio"/> Butane, Other (Describe) _____ H/P <i>1/2</i>		

DESCRIPTION OF FORMATIONS ENCOUNTERED	FROM	TO
<i>Red Dirt</i>	<i>0</i>	<i>10</i>
<i>Yellow Sand</i>	<i>10</i>	<i>40</i>
<i>Gray Clay</i>	<i>40</i>	<i>42</i>
<i>White Sand</i>	<i>42</i>	<i>45</i>
<i>Gray Clay</i>	<i>45</i>	<i>86</i>

WELL DATA		
Well Depth <i>86'</i>	Casing Diameter (In.) <i>4"</i>	Casing Length (Ft.) <i>96'</i>
Type of Casing <i>PVC</i>	Hole Depth <i>86'</i>	Depth to Static Water Level <i>27'</i>

TYPE OF COMPLETION: (Circle One or More):  
 Gravel Packed,  Underreamed,  Telescoped,  
 Natural Development,  Open Hole,  Other  
 (Describe) \_\_\_\_\_

WELL GROUTED TO A DEPTH OF *10* FEET  
 Type Grout (circle one): Cement, Bentonite, or Mix

SCREEN DATA		
Diameter - Inches <i>H</i>	Length - Feet <i>10</i>	Slot Size - Inches <i>.10</i>
Screen Type <i>PVC Saw-Slot</i>	Depth to Bottom - Feet	

**RECEIVED**

OCT 01 2002

**BY: OLWR**

Top of Lap Pipe or Reduction in Casing

FEET  IF TELESCOPED OR MORE THAN ONE SCREEN: USE BACK PAGE


I certify that the well was drilled, constructed and completed in accordance with all applicable Requirements of the Mississippi Department of Environmental Quality and/or the Mississippi Department of Health regulations and state laws.

*Paul J. Thomas 0-149* \_\_\_\_\_ *9-21-02*  
 Signature of Licensed Driller and License No. Date

Additional Information Required On Back

If well telescopes please sketch and show depths.

GROUND LEVEL

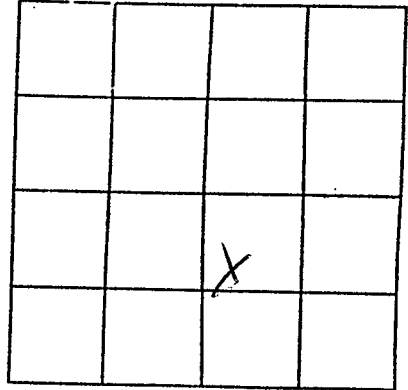

SECTION 2

Please indicate well location X.

Pump Capacity (GPM)	No. of Stages	Setting Depth
10	2	60' FT.

PUMP TEST

Well yielded 16 GPM with  
a drawdown of N/A ft.  
after \_\_\_\_\_ hours of pumping

LOG DATA

TYPE OF LOG RUN (Circle One): No Log Run,  
Electric, Gamma Ray, Density, Sonic, Neutron,  
Other (Describe) \_\_\_\_\_

Name of Organization Running Log

GEOLOGIC DATA (Office Use Only)

Surface Elev.	Geologic Unit	Unit Thickness	Depth to Top
Subs. SWL	Date	Analysis	Aquifer Test

Driller's Remarks

If more than one screen,  
show location of each on sketch.